15.159.00092.0001

STATE OF KANSAS
STATE CORPORATION COMMISSION

Give All Information Completely
Make Required Affidavit
Mail or Deliver Report to:
Conservation Division
State Corporation Commission
800 Bitting Building
Wichita, Kansas

WELL PLUGGING RECORD

NORTH

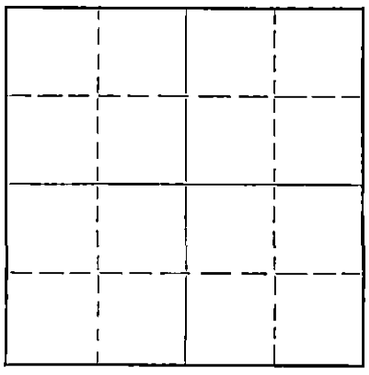

Locate well correctly on above Section Plat

Rice County. Sec. 7 Twp. 21 Rge. 6 ~~XXX~~ (W)

Location as "NE/CNW¼SW¼" or footage from lines SW NE

Lease Owner Branine-Holl

Lease Name Dresback Well No. 2

Office Address 822 Central Building, Wichita 2, Kansas

Character of Well (completed as Oil, Gas or Dry Hole) Dry Hole

Date well completed Reopened old hole 19

Application for plugging filed 12-20-53 19

Application for plugging approved 12-20-53 19

Plugging commenced 12-20-53 19

Plugging completed 12-26-53 19

Reason for abandonment of well or producing formation Dry hole

If a producing well is abandoned, date of last production 19

Was permission obtained from the Conservation Division or its agents before plugging was commenced? Yes. Verbally

Name of Conservation Agent who supervised plugging of this well Ruel Durkee

Producing formation Depth to top Bottom Total Depth of Well 3543 Feet

Show depth and thickness of all water, oil and gas formations.

OIL, GAS OR WATER RECORDS — CASING RECORD

Formation	Content	From	To	Size	Put In	Pulled Out
				5 1/2"	3486'	2698'

Describe in detail the manner in which the well was plugged, indicating where the mud fluid was placed and the method or methods used in introducing it into the hole. If cement or other plugs were used, state the character of same and depth placed, from feet to feet for each plug set.

Set bridge at bottom of hole, filled with sand to 3510', dumped 4 sacks cement, mudded to 180'; set bridge at 180'; 15 sacks of cement; mudded to 20'; 5 sacks cement from 20' to cellar.

(If additional description is necessary, use BACK of this sheet)

Correspondence regarding this well should be addressed to Branine-Holl

Address 822 Central Building, Wichita 2, Kansas

STATE OF Kansas, COUNTY OF Sedgwick, ss.

Joseph B. Brungardt, Jr. (employee of owner) or (~~XXXXXXXXXXXX~~) of the above-described well, being first duly sworn on oath, says: That I have knowledge of the facts, statements, and matters herein contained and the log of the above-described well as filed and that the same are true and correct. So help me God.

(Signature) Joseph B. Brungardt, Jr.

(Address)

SUBSCRIBED AND SWORN TO before me this 4th day of January, 19 54

Mildred Lindemuth
Notary Public.

My commission expires July 19, 1956

23-3273-s 4-50—10M

PLUGGING
FILE SEC. 7 T. 21 R. 6W
BOOK PAGE 3 LINE 3

1-9-1954