


WELL PLUGGING RECORD

Give All Information Completely
Make Required Affidavit
Mail or Deliver Report to:
Conservation Division
State Corporation Commission
800 Bittling Building
Wichita, Kansas

Rice County, Sec. 7 Twp. 21 Rge. 6 (E) (W)
Location as "NE/CNW/SW" or footage from lines SW SW NW
Lease Owner Henry Bennett
Lease Name Dresbeck Well No. 4
Office Address Union National Bank Bldg., Wichita, Ks.
Character of Well (completed as Oil, Gas or Dry Hole) Dry Hole
Date well completed 1-27-56 19 56
Application for plugging filed 1-27 19 56
Application for plugging approved 1-27 19 56
Plugging commenced 1-27 19 56
Plugging completed 1-27 19 56
Reason for abandonment of well or producing formation Dry Hole

NORTH

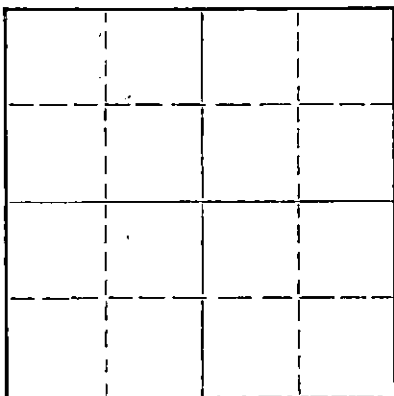

Locate well correctly on above
Section Plat

If a producing well is abandoned, date of last production 19
Was permission obtained from the Conservation Division or its agents before plugging was commenced? Yes

Name of Conservation Agent who supervised plugging of this well Ruel Durkee
Producing formation _____ Depth to top _____ Bottom _____ Total Depth of Well 3530 Feet
Show depth and thickness of all water, oil and gas formations.

OIL, GAS OR WATER RECORDS

CASING RECORD

FORMATION	CONTENT	FROM	TO	SIZE	PUT IN	PULLED OUT
				8 5/8	247'	None

Describe in detail the manner in which the well was plugged, indicating where the mud fluid was placed and the method or methods used in introducing it into the hole. If cement or other plugs were used, state the character of same and depth placed, from _____ feet to _____ feet for each plug set.

Gunned pits to raise viscosity of mud. Filled hole with heavy mud to bottom of drill pipe, namely: 250'. Built bridge with hulls at 250' and put fifteen sacks cement through 7 joints of drill pipe on top of hulls. Filled hole with mud to 20'. Built bridge at 20' and ran 5 sacks cement filling hole to top of cellar.

(If additional description is necessary, use BACK of this sheet)

Name of Plugging Contractor _____
Address _____


STATE OF Kansas COUNTY OF Saline ss.
Loren W. Hallam (employee of owner) or (owner or operator) of the above-described well, being first duly sworn on oath, says: That I have knowledge of the facts, statements, and matters herein contained and the log of the above-described well as filed and that the same are true and correct. So help me God.

(Signature) Loren W. Hallam
Salina, Kansas. (Address)

SUBSCRIBED AND SWORN TO before me this 27th day of January, 19 56

Jean M. Callough
Notary Public.

My commission expires 2-26-58

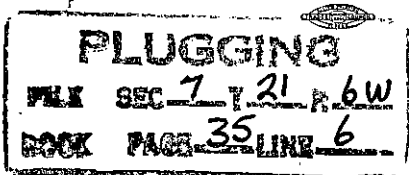

2-3-1956
REGISTRATION

ROTARY DRILLER'S LOG

Dresbeck #4

Elevation: 1670

Legal Description: SW SW NW
Sec. 7, Twp. 21, Range 6, Rice
County.

Casing Record:
247' 8 5/8 with 250 sacks
Pozmix—2% cc

Operator: Henry Bennett
Wichita, Kansas.

Contractor: Salina Drilling Corporation, Inc.
102 Ins. Building,
Wichita, Kansas.

Well Commenced 1-1-56

Geologist: Charles Brown
Wichita, Kansas.

Well Completed 1-27-56

Surface Clay and sand	60
Shale and Shells	110
Shale-Shells-Red Bed	820
Shale	1000
Lime and Shale	1110
Lime	1560
Lime and Shale	2165
Lime-Shale-Sand	2595
Lime and Shale	2655
Lime	2695
Lime and Shale	2715
Lime	2750
Lime and Sand	2800
Sand-Shale-Lime	2860
Lime and Shale	3055
Lime	3340
Lime and Shale	3483
Conglomerate	3501
Mississippi	3530 T. D.

TOPS AS PICKED BY GEOLOGIST

Conglomerate	3483	Mississippi	3501
--------------	------	-------------	------

I certify the above is true and correct to the best of my knowledge.

Loren S. Hallen

Subscribed to and sworn this 27th day of January, 1956.

My commission expires 2-26-58

James McCullough
Notary Public

PLUGGING
 WEL SEC 7 T 21 R 6W
 BOOK PAGE 35 LINE 6