

STATE OF KANSAS
STATE CORPORATION COMMISSION


WELL PLUGGING RECORD

Give All Information Completely
Make Required Affidavit
Mail or Deliver Report to:
Conservation Division
State Corporation Commission
800 Bittling Building
Wichita, Kansas

OR
FORMATION PLUGGING RECORD

Strike out upper line
when reporting plugging
of formations.

NORTH

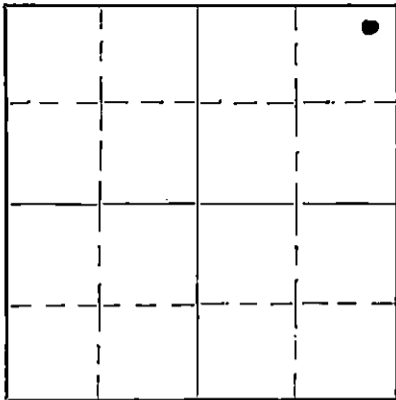

Locate well correctly on above
Section Plat

Rice County. Sec. 17 Twp. 21 Rge. (E) 7 (W)
Location as "NE 1/4 NW 1/4 SW 1/4" or footage from lines. NE 1/4 NW 1/4
Lease Owner Aylward Prod. Co., & H. S. Moss Petro. Co.
Lease Name Johnson Well No. 6
Office Address 708 Ellis-Singleton Bldg., Wichita, Kansas.
Character of Well (completed as Oil, Gas or Dry Hole) Oil
Date, well completed April 30, 1937 193
Application for plugging filed August 10, 1939 193
Application for plugging approved 193
Plugging Commenced August 15, 1939 193
Plugging Completed August 17, 1939 193
Reason for abandonment of well or producing formation Well did not pay to produce

If a producing well is abandoned, date of last production August 10, 1939
Was permission obtained from the Conservation Division or its agents before plugging was commenced? Yes

Name of Conservation Agent who supervised plugging of this well
Producing formation Conglomerate Depth to top 3367 Bottom 3384 Total Depth of Well 3384 Feet
Show depth and thickness of all water, oil and gas formations.


OIL, GAS OR WATER RECORDS

CASING RECORD

Formation	Content	From	To	Size	Put In	Pulled Out
				10"	131'	None
				7" O.D.	3350'	2884'

Describe in detail the manner in which the well was plugged, indicating where the mud fluid was placed and the method or methods used in introducing it into the hole. If cement or other plugs were used, state the character of same and depth placed, from _____ feet to _____ feet for each plug set.
Put in cement plug at 3422' to 3370', then filled with mud to 130' from top, cemented with 15' plug "Cement", filled with mud to top, then capped same with cement plug.

PLUGGING
FILE SEC-17-T-21-R-7W
BOOK PAGE 72 LINE 32

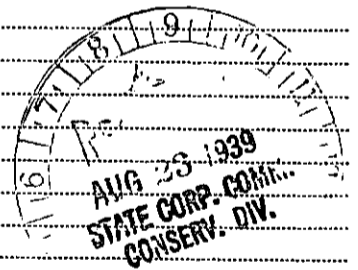

(If additional description is necessary, use BACK of this sheet)

Correspondence regarding this well should be addressed to The Aylward Production Company
Address 708 Ellis-Singleton Building, Wichita, Kansas.

STATE OF Kansas, COUNTY OF Sedgwick
J. D. Crawford Plugging contractor

(employee of owner) or (owner or operator) of the above-described well,
being first duly sworn on oath, says: That I have knowledge of the facts, statements, and matters herein contained and the log of the above-described well as filed and that the same are true and correct. So help me God.

(Signature) J. D. Crawford
Box 1811, Wichita, Kansas.
(Address)

SUBSCRIBED AND SWORN TO before me this 22nd day of August, 1939.

My commission expires January 19, 1943.

Alfred F. Shalby
Notary Public.

ROTARY LOG

JOHNSON WELL NO. 6

Casing Record:

10" - 131' Cemented
 7" OD - 3350' "
 5 3/16" Liner - 49' set
 at 3367'

Company: The Aylward Production Company,
 H. S. Moss Petroleum Company
 Contractor: The Aylward Production Co.

Location:
 NE 1/4 of
 Sec. 17-21S-7W
 Rice County, Kans.

Commenced: March 10, 1937
 Completed: April 30, 1937

Elevation: 1616'
 Production:

<u>Formation</u>	<u>From</u>	<u>To</u>	<u>Remarks</u>
Surface	0	120	
shale	120	131	Set 10" Casing at 131' and cemented with 160 sacks.
lime shells & shale	131	650	
salt & shale	650	915	
lime shells & shale breaks	915	1080	
shale lime	1080	1290	
lime broken	1290	1405	
shale lime	1405	1488	
lime broken	1488	1540	
lime	1540	1615	
lime broken	1615	1718	
shale lime shells	1718	1937	
shale shells	1937	2036	
shale	2036	2136	
lime	2136	2204	
lime shale	2204	2280	
shale lime shells	2280	2306	
lime	2306	2380	
lime broken	2380	2403	
lime	2403	2768	
shale	2768	2800	
lime	2800	2825	
shale lime	2825	2870	
lime	2870	3245	
lime broken	3245	3255	
lime shale	3255	3281	
lime broken	3281	3310	
lime & shale	3310	3342	
shale	3342	3350	Set 7" OD Casing at 3350' and cemented with 75 sacks.
shale blue	3350	3357	
conglomerate	3357	3360	
sand	3360	3367	Set 49' of 5 3/16" Liner at 3367' First show oil at 3370' Gas at 3375'
conglomerate	3367	3384	
			Conglomerate showing chat at 3384'

PLUGGING
 FILE NO. 17-21S-7W
 BOOK PAGE 72 LINE 32