


WELL PLUGGING RECORD

Give All Information Completely
Make Required Affidavit
Mail or Deliver Report to:
Conservation Division
State Corporation Commission
800 Bittling Building
Wichita, Kansas

Rice County. Sec. 17 Twp 21 Rge. (E) 7 (W)
Location as "NE/CNW $\frac{1}{4}$ /SW $\frac{1}{4}$ " or footage from lines NW NW SW
Lease Owner Thos. H. Allan
Lease Name Ball Well No. 1
Office Address 1221 Union National Bank Bldg., Wichita 2, Kansas
Character of Well (completed as Oil, Gas or Dry Hole) Dry Hole
Date well completed July 4 19 51
Application for plugging filed July 4 19 51
Application for plugging approved July 4 19 51
Plugging commenced July 4 19 51
Plugging completed July 5 19 51
Reason for abandonment of well or producing formation Dry Hole

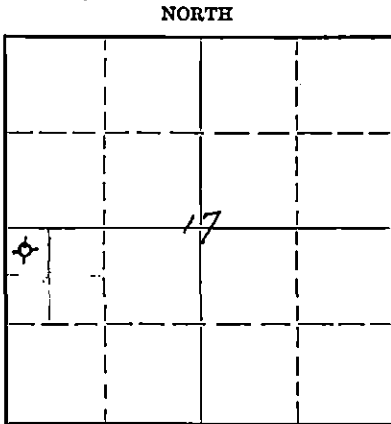

Locate well correctly on above Section Plat

If a producing well is abandoned, date of last production 19...
Was permission obtained from the Conservation Division or its agents before plugging was commenced? Yes

Name of Conservation Agent who supervised plugging of this well Ruel Durkee
Producing formation Conglomerate Depth to top Missing Bottom Total Depth of Well 3420 Feet
Show depth and thickness of all water, oil and gas formations.

OIL, GAS OR WATER RECORDS

CASING RECORD

Formation	Content	From	To	Size	Put In	Pulled Out
				8 5/8"	142'	None
				5 1/2"	3371'	2715'

Describe in detail the manner in which the well was plugged, indicating where the mud fluid was placed and the method or methods used in introducing it into the hole. If cement or other plugs were used, state the character of same and depth placed, from... feet to... feet for each plug set.

3420 - 3365 6 sacks of cement
3365 - 140 Heavy Rotary mud
140 - 100 Solid Bridge and 15 sacks cement
100 - 15 Mud
15 - Surface 5 sacks cement

RECEIVED
STATE CORPORATION COMMISSION
JUL 17 1951
CONSERVATION DIVISION
Wichita, Kansas

(If additional description is necessary, use BACK of this sheet)
Correspondence regarding this well should be addressed to Thos. H. Allan
Address 1221 Union National Bank Bldg., Wichita 2, Kansas

STATE OF KANSAS, COUNTY OF SEDGWICK, ss.
Thos. H. Allan (employee of owner) or (owner or operator) of the above-described well,
being first duly sworn on oath, says: That I have knowledge of the facts, statements, and matters herein contained and the log of the above-described well as filed and that the same are true and correct. So help me God.

(Signature) Thos. H. Allan
1221 Union Nat'l Bank Bldg., Wichita 2, Kansas
(Address)

SUBSCRIBED AND SWORN TO before me this 10th day of July, 1951
Ocie M. Stewart
Notary Public.

My commission expires June 14, 1954

PLUGGING
FILE SEC 17 21 7W
BOOK PAGE 95 LINE 41

8 5/8" @ 142' - 130 sx
 5 1/2" @ 3371' - 75 sx

THOS. H. ALLAN #1 BALL
 NW NW SW 17-21-7W
 Rice County, Kansas
 Comm: 6/8/51 Compl: 7/5/51
 Contractor: Tom Allan
 Elevation: 1623 D.F.
 1625 R.B.
 I.P. D & A

Depth from Rotary Bushings

0 - 80 Coarse gravel
 195 Red shale
 450 Red & Green shale with
 Anhydrite stringers
 700 Gray shale
 1010 Salt & shale
 1220 Shale & Anhydrite
 1250 Shale
 1310 Lime & shale
 1350 Lime
 1410 Lime & shale
 1440 Lime & chert
 1810 Lime & shale
 1840 Lime
 1940 Shale
 2000 Lime & shale
 2060 Red & Gray shale
 2100 Shale
 2160 Lime & shale
 2190 Shale
 2220 Lime & shale
 2280 Lime
 2340 Lime & shale
 2380 Lime
 2440 Lime & shale
 2560 Lime
 2640 Lime & chert
 2750 Lime with Shale breaks
 2780 Lime & shale
 2850 Sand & shale
 2880 Lime & shale
 2900 Sand, shale & lime
 3010 Lime
 3060 Lime & chert
 3125 Lime & shale
 3165 Lime
 3265 Lime & Shale
 3325 Lime & Red & Green shale
 3356 Red & Green shale
 3358 Vari-colored chert
 3369 Red & Green shale
 3372 White chert & Tripoli, Oil stained
 RTD 3372 RB = 3370 DF

3381 DF Weathered white chert &
 Tripoli (Made 3 bbl. oil
 in 7 1/2 hr.)
 3386 DF Fresh white chert (Filled
 up 18' per hr. with oil &
 trace of water)
 Hydrafrac 3369-86 DF No increase
 3418 DF White chert
 3420 DF (TD) Red & Green shale

FORMATIONS:

Lansing 2912 DF
 Cherty Conglomerate 3354 DF
 Mississippian 3367 DF
 Kinderhook 3418 DF


I certify that the above is a true and
 correct copy of the well log on the above
 test.

Thomas H. Allan

Subscribed and sworn to before me this
 6th day of July, 1951.

Orce M. Stewart
 Notary Public

My Commission expires June 14, 1954

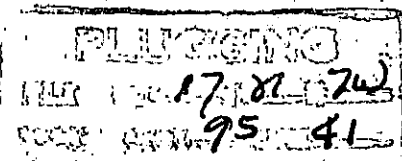

STATE OF KANSAS
 NOTARY PUBLIC COMMISSION

JUL 17 1951

WICHITA, KANSAS