


STATE OF KANSAS
STATE CORPORATION COMMISSION

WELL PLUGGING RECORD

Give All Information Completely
Make Required Affidavit
Mail or Deliver Report to:
Conservation Division
State Corporation Commission
800 Bittling Building
Wichita, Kansas

OR
FORMATION PLUGGING RECORD Strike out upper line when reporting plugging of formations.

Rice County. Sec. 17 Twp. 21S Rge. (E) 7 (W)
Location as "NE 1/4 NW 1/4 SW 1/4" or footage from lines NE Corner N/2 NW/4
Lease Owner The Atlantic Refining Company
Lease Name Potts Well No. 1
Office Address Box 17, Great Bend, Kansas
Character of Well (completed as Oil, Gas or Dry Hole) Oil
Date well completed 3-24 1937
Application for plugging filed 9-3 1951
Application for plugging approved 9-1 1951
Plugging commenced 10-23 1951
Plugging completed 11-6 1951
Reason for abandonment of well or producing formation Well production declined to where it is not profitable to operate.
If a producing well is abandoned, date of last production August 20 1951
Was permission obtained from the Conservation Division or its agents before plugging was commenced? Yes

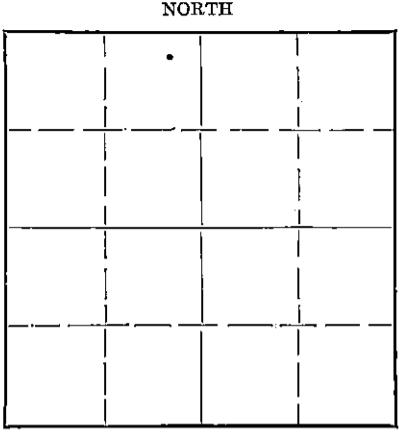

Locate well correctly on above Section Plat

Name of Conservation Agent who supervised plugging of this well ~~XES~~ Mr. Ruel Durkee
Producing formation 3376 to 3407 Cong. Depth to top 3376 Bottom 3407 Total Depth of Well 3407 Feet
Show depth and thickness of all water, oil and gas formations.

OIL, GAS OR WATER RECORDS

CASING RECORD

Formation	Content	From	To	Size	Put In	Pulled Out
				12-1/2"	100'	0
				7"	3376'	2513'

Describe in detail the manner in which the well was plugged, indicating where the mud fluid was placed and the method or methods used in introducing it into the hole. If cement or other plugs were used, state the character of same and depth placed, from _____ feet to _____ feet for each plug set.

Sand 3407 to 3365'
Six sacks cement 3365 to 3347'
Mud 3347 to 100'
Bridge 100' to 90'
25 sacks cement 90' to 75'
Mud 75' to 25'
Bridge 25' to 18'
Eighteen sacks cement 18' to 5'

(If additional description is necessary, use BACK of this sheet)

Correspondence regarding this well should be addressed to The Atlantic Refining Co.
Address Box 17, Great Bend, Kansas

STATE OF Kansas, COUNTY OF Barton, ss.

(employee of owner) or (owner or operator) of the above-described well, being first duly sworn on oath, says: That I have knowledge of the facts, statements, and matters herein contained and the log of the above-described well as filed and that the same are true and correct. So help me God.

(Signature) Stanton H. Meyer
Box 17, Great Bend, Kansas
(Address)

SUBSCRIBED AND SWORN to before me this 12th day of November, 1951

My commission expires July 29, 1955

Notary Public

PLUGGING
FILE SEC-712-R-70
BOOK PAGE 106 LINE 37

22-2625 2-48-15M

NOV 13 1951
CONSERVATION DIVISION
Wichita, Kansas

WELL RECORD

15.159.05470.0000

Block or Twp. 218

Lease Potts
Lease No. KS-5999
County Rice

Well No. 1
State Kansas

Location Ne/Cor N/2 NW/4
17-21S-7W
Elevation Feet

Drilled { Contract
Company Tools

Contracted Depth
Completed Depth

Feet Date { Started 1-12-37
Completed 3-24-37
Deepened
Cleaned Out

Name of Contractor Reading & Bates

Contract Price 3.50 Per Foot

Day Work

Well Estimated Cost
Well Actual Cost

Method of Drilling Rotary with
Cable tool completion.

BEFORE SHOOTING

AFTER SHOOTING

initial Production
Settled Production

Flowing
on Pump

Initial Production
Settled Production

Flowing
on Pump

Baume Test

Water With Oil

%

Casing Record

Torpedo Record

SIZE	SET	PULLED	Date	Company	From	To	Feet	Size of Shell	Total Qts.
12 1/8"	100'	none			3375		3390		60
7"	3376'	none							

STATE OF KANSAS
NOV - 7 1957
COMMISSIONER OF GEOLOGY
Wichita, Kansas

FORMATION	TOP	BOTTOM	FORMATION	TOP	BOTTOM
Surface clay	0	80	Lime and shale	3100	3160
Red bed	80	100	Lime	3160	3266
Shale and shells	100	275	Lime and shale	3266	3355
Sand and shale	275	560	Sand shale	3355	3359
Shale and shells	560	890	shale and shells	3359	3376
Sand and shale	890	1266	Coring	3376	3377
Shale shells	1266	1290	Sand	3377	3380
Lime	1290	1420	Conglomerate	3380	3395
Sand shale	1420	1515	Chat	3395	3407 T.D.
Shale and shells	1515	1795			
Shale	1795	2180			
Lime and shale	2180	2200			
Lime	2200	2277			
Lime and shale	2277	2350			
Lime	2350	2380			
Shale	2380	2455			
Hard lime	2455	2477			
Shale	2477	2494			
Shale and lime	2494	2500			
Hard lime	2500	2657			
Lime and shale	2657	2675			
Lime	2675	2695			
Shale and lime	2695	2720			
Lime	2720	2860			
Lime and shale	2860	2890			
Lime	2890	2915			
Shale	2915	2920			
Lime	2920	3100			

PLUGGING
DATE DEC 17 1957
WELL NO. 17-21S-7W
BLOCK PAC 10.6 LINE 38