


STATE OF KANSAS
STATE CORPORATION COMMISSION

Give Information Completely
Make Required Affidavit
Mail or Deliver Report to:
Conservation Division
State Corporation Commission
P. O. Box 17027
Wichita, Kansas 67217
NORTH

WELL PLUGGING RECORD

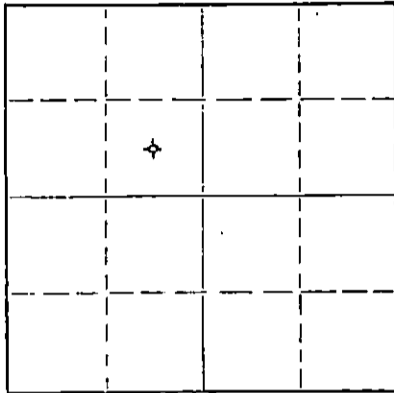

Locate well correctly on above
Section Plat

Hodgeman County, Sec. 35 Twp. 21 Rge. 24W (E) (W)
Location as "NE/CNW/SW" or footage from lines C SE NW
Lease Owner Donald C. Slawson
Lease Name Goebel "G" Well No. 1
Office Address 408 120 Bldg. Wichita, Kansas 67202
Character of Well (completed as Oil, Gas or Dry Hole) Dry Hole
Date well completed October 4 1974
Application for plugging filed October 4 1974
Application for plugging approved October 4 1974
Plugging commenced October 4 1974
Plugging completed October 4 1974
Reason for abandonment of well or producing formation Dry Hole

If a producing well is abandoned, date of last production 19
Was permission obtained from the Conservation Division or its agents before plugging was commenced? yes

Name of Conservation Agent who supervised plugging of this well Clarence Thomas, 403 Davis, Garden City, Ks.
Producing formation _____ Depth to top _____ Bottom _____ Total Depth of Well 4662 Feet
Show depth and thickness of all water, oil and gas formations.

OIL, GAS OR WATER RECORDS

CASING RECORD

| FORMATION | CONTENT | FROM | TO | SIZE | PUT IN | PULLED OUT |
|-----------|----------|------|----|------|--------|------------|
| 8 5/8" | 582 feet | | | | 589 | |
| | | | | | | |
| | | | | | | |
| | | | | | | |
| | | | | | | |
| | | | | | | |
| | | | | | | |
| | | | | | | |

Describe in detail the manner in which the well was plugged, indicating where the mud fluid was placed and the method or methods used in introducing it into the hole. If cement or other plugs were used, state the character of same and depth placed, from _____ feet to _____ feet for each plug set.

1st plug @ 850 ' w/80 sx
2nd plug @ 550 ' w/35 sx
3rd plug @ 45 ' w/ 15 sx

RECEIVED
STATE CORPORATION COMMISSION
OCT 17 1974
CONSERVATION DIVISION
Wichita, Kansas

(If additional description is necessary, use BACK of this sheet)

Name of Plugging Contractor Slawson Drilling Company, Inc.
Address 408 120 Bldg. Wichita, Kansas 67202

STATE OF Kansas, COUNTY OF Sedgwick, ss.
James C. Remsberg (employee of owner) or (owner or operator) of the above-described well, being first duly sworn on oath, says: That I have knowledge of the facts, statements, and matters herein contained and the log of the above-described well as filed and that the same are true and correct. So help me God.

(Signature) James C. Remsberg
James C. Remsberg
(Address)

SUBSCRIBED AND SWORN to before me this 16th day of October 1974

My commission expires _____
DOLORES B. COADY
STATE NOTARY PUBLIC
SEDGWICK COUNTY, KANSAS
Comm. Expires Mar. 7, 1976

Dolores B. Coady
Notary Public.

WELL LOG

COMPANY: Donald C. Slawson
 408 120 Building
 Wichita, Kansas 67202

LEASE: Goebel 'G' #1
 C SE NW 35-21-24W
 Hodgeman County, Kansas

TOTAL DEPTH 4662 feet

CONTRACTOR: Slawson Drilling Company, Inc.

COMMENCED: September 25, 1974

COMPLETED: October 4, 1974

CASING: Set 8 5/8" @ 589' w/400 sx

| | |
|-----------|----------------|
| 0-592 | Surface Hole |
| 592-2458 | Shale & Shells |
| 2458-4025 | Lime & Shale |
| 4025-4535 | Lime |
| 4535-4605 | Lime & Shalw |
| 4605-4662 | Lime |
| 4662 | RTD |

RECEIVED
 STATE CORPORATION COMMISSION
 OCT 17 1974
 CONSERVATION DIVISION
 Wichita, Kansas

STATE OF KANSAS)
)
 COUNTY OF SEDGWICK)

I, James C. Remsberg, of the Slawson Drilling Company, Inc. upon oath state that the above and foregoing is a true and correct copy of the log of the Goebel "G" #1 well.

James C. Remsberg
 JAMES C. REMSBERG

Subscribed and sworn to before me this 16th day of October, 1974.

Dolores B. Coady
 Dolores B. Coady, Notary Public

My Commission Expires:

DOLORES B. COADY
 STATE NOTARY PUBLIC
 SEDGWICK COUNTY, KANSAS