


STATE OF KANSAS
STATE CORPORATION COMMISSION

Form CP-4

Give All Information Completely
Make Required Affidavit
Mail or Deliver Report to:
Conservation Division
State Corporation Commission
212 No. Market
Wichita, Kansas

WELL PLUGGING RECORD

NORTH

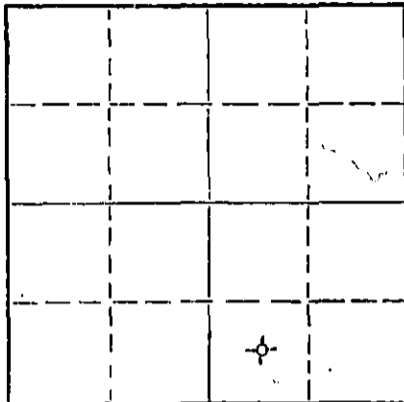

Locate well correctly on above
Section Plat

Hodgeman County, Sec. 10 Twp. 21 Rge. 25W XXXXX (W)
Location as "NE/CNW/SW" or footage from lines C SW SE
Lease Owner Rockford-Mineral Products, Inc.
Lease Name Ploger Well No. 1
Office Address 1618 Wichita Plaza, Wichita, Kansas
Character of Well (completed as Oil, Gas or Dry Hole) dry hole
Date well completed 12/22/67 19
Application for plugging filed 12/27/67 19
Application for plugging approved 12/22/67 19
Plugging commenced 12/22/67 19
Plugging completed 12/22/67 19
Reason for abandonment of well or producing formation D & A

If a producing well is abandoned, date of last production 19
Was permission obtained from the Conservation Division or its agents before plugging was commenced? yes

Name of Conservation Agent who supervised plugging of this well Edger Eyes
Producing formation Depth to top Bottom Total Depth of Well 4895 Feet
Show depth and thickness of all water, oil and gas formations.

OIL, GAS OR WATER RECORDS

CASING RECORD

FORMATION	CONTENT	FROM	TO	SIZE	PUT IN	PULLED OUT
shale, sand and post rock		0	180			
shale			280'	8 5/8"	280'	-0-

Describe in detail the manner in which the well was plugged, indicating where the mud fluid was placed and the method or methods used in introducing it into the hole. If cement or other plugs were used, state the character of same and depth placed, from feet to feet for each plug set.

Bottom plug @ 950' w/100 sx cement
Middle plug @ 280' w/30 sx cement
Top plug @ 45' w/15 sx cement

RECEIVED
STATE CORPORATION COMMISSION
DEC 29 1967

(If additional description is necessary, use BACK of this sheet)
Name of Plugging Contractor Vaughan Drilling, Inc.
Address 1618 Wichita Plaza, Wichita, Kansas

STATE OF Kansas, COUNTY OF Sedgwick, ss.
Donald D. Vaughan (employee of owner) or (owner or operator) of the above-described well, being first duly sworn on oath, says: That I have knowledge of the facts, statements, and matters herein contained and the log of the above-described well as filed and that the same are true and correct. So help me God.

(Signature) *Donald D. Vaughan*
1618 Wichita Plaza, Wichita, Kansas
(Address)

SUBSCRIBED AND SWORN TO before me this 27th day of December, 19 67.

My commission expires 3/10/71
Carolyn Sinning Notary Public.

WELL LOG

COMPANY Rockford-Mineral, Products, Inc.
 CONTRACTOR ~~XXXXXXXXXXXXXXXXXXXXXXXXXXXX~~
 FARM# Vaughan Drilling, Inc.
 LOCATION #1 Ploger
 C SW SE Section 10-21-25W
 Hodgeman County, Kansas
 ELEVATION 2313 KB
 SURFACE PIPE 8 5/8" 2 280' w/175sx
 PRODUCTION D & A
 COMMENCED 12/5/67
 COMPLETED 12/22/67

FORMATION	DEPTH
shale, sand, post rock	180'
shale	311
shale and red bed	1130
sand	1245
shale, shells, red bed	1492
Anhydrite	1530
shale	1590
Anhy. streaks	1605
shale and shells	1910
shale and lime streaks	2312
shale and lime	3020
chalk and lime	3121
lime and shale	3940
lime	4070
lime and shale	4363
lime and sand	4370
lime and shale	4410
lime	4445
lime and chert	4482
lime	4586
lime w/chert	4654
lime	4735
lime w/chert	4775
lime	4838
lime and shale	4886
lime	4895

RECEIVED
STATE CORPORATION COMMISSION

DEC 29 1967

A F F I D A V I T

STATE OF KANSAS
COUNTY OF SEDGWICK

CONSERVATION DIVISION
Wichita, Kansas

I, Donald D. Vaughan, of the VAUGHAN DRILLING, INC., being first duly sworn on oath, state that I have knowledge of the facts, statements and matters herein contained and that the same are true and correct.

Donald D. Vaughan
Donald D. Vaughan, President

Subscribed and sworn to before me this 28th day of December 1967

My commission expires: 3/10/71

Carolyn Sinning
Carolyn Sinning NOTARY