

STATE OF KANSAS  
STATE CORPORATION COMMISSION

Give All Information Completely  
Make Required Affidavit  
Mail or Deliver Report to:  
Conservation Division  
State Corporation Commission  
211 No. Broadway  
Wichita, Kansas

WELL PLUGGING RECORD

Hodgeman County, Sec. 7 Twp. 21S Rge. 25W (E) (W)

Location as "NE/CNW/SE/SW" or footage from lines C NE NW

Lease Owner Thunderbird Drilling, Inc.

Lease Name Sinclair 'H' Well No. 1

Office Address P.O. Box 18407- Wichita, Kansas 67218

Character of Well (completed as Oil, Gas or Dry Hole) Dry Hole

Date well completed 3/26/77 19

Application for plugging filed 3/26/77 19

Application for plugging approved 3/26/77 19

Plugging commenced 3/26/77 19

Plugging completed 3/26/77 19

Reason for abandonment of well or producing formation Dry Hole

If a producing well is abandoned, date of last production 19

Was permission obtained from the Conservation Division or its agents before plugging was commenced? Yes

Name of Conservation Agent who supervised plugging of this well Leo Massey

Producing formation \_\_\_\_\_ Depth to top \_\_\_\_\_ Bottom \_\_\_\_\_ Total Depth of Well \_\_\_\_\_ Feet

Show depth and thickness of all water, oil and gas formations.

OIL, GAS OR WATER RECORDS

CASING RECORD

FORMATION	CONTENT	FROM	TO	SIZE	PUR IN	PULLED OUT
	Surf. Csg.	0	284'	8-5/8"	284	0

Describe in detail the manner in which the well was plugged, indicating where the mud fluid was placed and the method or methods used in introducing it into the hole. If cement or other plugs were used, state the character of same and depth placed, from \_\_\_\_\_ feet to \_\_\_\_\_ feet for each plug set.

1st Plug @ 900' w/50 sx

2nd Plug @ 300' w/15 sx

3rd Plug @ 40' w/15 sx

(If additional description is necessary, use BACK of this sheet)

Name of Plugging Contractor Thunderbird Drilling, Inc.

Address P.O. Box 18407- Wichita, Kansas 67218

STATE OF Kansas COUNTY OF Sedgwick, ss.

Burke Krueger

(employee of owner) or (owner or operator) of the above-described

well, being first duly sworn on oath, says: That I have knowledge of the facts, statements, and matters herein contained and the log of the above-described well as filed and that the same are true and correct. So help me God.

(Signature) *Burke Krueger*

P.O. Box 18407- Wichita, Kansas 67218


(Address)

SUBSCRIBED AND SWORN to before me this 1st day of April, 1977

*Gloria DeJesus*

Notary Public.

My commission expires 3-25-80

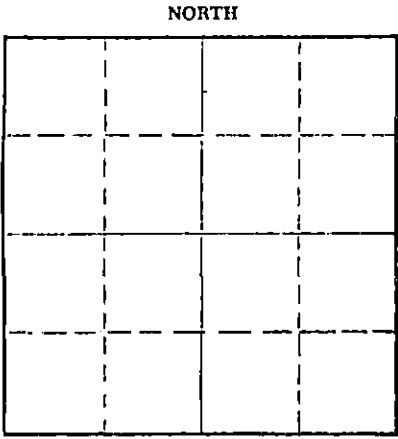

Locate well correctly on above Section Plat

DRILLERS LOG

Company Thunderbird Drilling, Inc. Contractor Thunderbird Drilling, Inc.

Elevation 2396' K.B.

Farm Sinclair "H"

Well No. 1 Casing 8-5/8" @ 284' w/225 sx

Location C NE NW Sec. 7-21S-25W

Production

County Hodgeman

<u>From</u>	<u>To</u>	<u>Description</u>
0	275	Surface Hole
275	530	Shale & Sand
530	803	Shale & Red bed
803	828	Sand
828	1086	Shale & Shells
1086	1320	Sand
1320	1636	Shale
1636	1667	Anhydrite
1667	1841	Shale
1841	2427	Shale & Shells
2427	3980	Shale & Lime
3980	4110	Lime & Shale
4110	4363	Shale & Lime
4363	4472	Lime
4472	T.D.	

APR 1 1977

STATE OF KANSAS )  
 ) ss.  
 COUNTY OF SEDGWICK )

I, Burke Krueger, of Thunderbird Drilling, Inc. upon oath states that the above and foregoing is a true and correct copy from the Daily Drilling Report from your Sinclair "H" #1.

Burke Krueger

Subscribed and sworn to before me this 1st day of April, 1977.

Gloria DeJesus  
 Notary Public



My commission expires: March 25, 1980