

STATE OF KANSAS
STATE CORPORATION COMMISSION


Form CP-4

Give All Information Completely
Make Required Affidavit
Mail or Deliver Report to:
Conservation Division
State Corporation Commission
212 No. Market
Wichita, Kansas 67202

WELL PLUGGING RECORD

McPherson County, Sec. 23 Twp. 21 Rge. 2W ~~XXE~~ (W)

Location as "NE/CNW/SW" or footage from lines CEL. NE/4 NW/4
Lease Owner Hess Oil Company
Lease Name Orland Unruh Well No. 1
Office Address P.O. Box 89, McPherson, Ks. 67460
Character of Well (completed as Oil, Gas or Dry Hole) Dry Hole
Date well completed April 6, 19 77
Application for plugging filed 19
Application for plugging approved 19
Plugging commenced 19
Plugging completed April 6, 19 77
Reason for abandonment of well or producing formation Dry

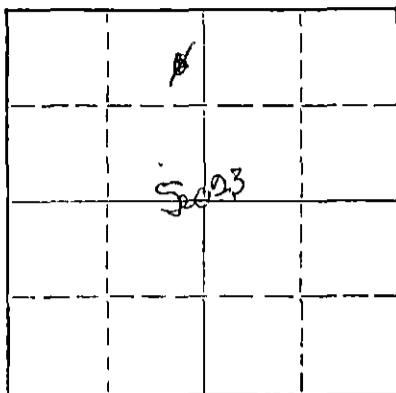

Locate well correctly on above Section Plat

If a producing well is abandoned, date of last production 19
Was permission obtained from the Conservation Division or its agents before plugging was commenced? Yes

Name of Conservation Agent who supervised plugging of this well Hugh Scott, McPherson, Ks.
Producing formation _____ Depth to top _____ Bottom _____ Total Depth of Well _____ Feet
Show depth and thickness of all water, oil and gas formations.

OIL, GAS OR WATER RECORDS

CASING RECORD

FORMATION	CONTENT	FROM	TO	SIZE	PUT IN	PULLED OUT
Clay		0	65	8 5/8"	65'	None
Blueshale		65'	112'	8 5/8"	47'	None

Describe in detail the manner in which the well was plugged, indicating where the mud fluid was placed and the method or methods used in introducing it into the hole. If cement or other plugs were used, state the character of same and depth placed, from _____ feet to _____ feet for each plug set.

Filled hole with mud to 160' & set plug with 25 sacks of cement. Filled hole with mud to 40' and set plug with 10 sacks of cement, 2 sacks in rat hole. Plugging completed at 6:30 A. M., April 6, 1977 by State Plugger, Hugh Scott, McPherson, Kansas 67460.

RECEIVED
STATE CORPORATION COMMISSION

APR 13 1977 4-13-1977

CONSERVATION DIVISION
Wichita, Kansas

Name of Plugging Contractor Blackstone Drilling, INC. (If additional description is necessary, use BACK of this sheet)
Address Box 1184, McPherson, Kansas 67460

STATE OF Kansas, COUNTY OF McPherson, ss.
Hess Oil Company (employee of owner) or (owner or operator) of the above-described well, being first duly sworn on oath, says: That I have knowledge of the facts, statements, and matters herein contained and the log of the above-described well as filed and that the same are true and correct. So help me God. HESS OIL COMPANY

(Signature) BY: George R. Hess
P.O. Box 89, McPherson, Kansas 67460
(Address)

SUBSCRIBED AND SWORN TO before me this _____ day of _____, 19 _____

My commission expires _____

Notary Public.



Blackstone Drilling, Inc.

Box 1184 • 523 West Kansas • Phone (316) 241-1250
McPHERSON, KANSAS 67460

April 7, 1977

COMPANY: HESS OIL COMPANY
 CONTRACTOR: BLACKSTONE DRILLING, INC.
 FARM: ORLANDO UNRUH #1
 LOCATION: CEL NE/4 NW/4, Sec. 23-21-2W,
 McPherson County, Kansas
 COMMENCED: March 31, 1977
 COMPLETED: April 6, 1977
 ELEVATION:

0	to	65	Clay
65	to	112	Blueshale
112	to	560	Shale
560	to	870	Lime & Shale
870	to	1100	Lime
1100	to	1680	Shale
1680	to	1985	Shale & Lime
1985	to	2805	Lime
2805	to	2998	Lime & Shale
2998	to	3170	Mississippi
3170	to	3255	Lime
3255	to	3365	Lime & Shale
		3365	T. D.

RECEIVED
STATE COMMISSIONER OF GEOL.

APR 13 1977

CONSERVATION DIVISION
Wichita, Kansas

Cur 12 $\frac{1}{2}$ " hole to 112' and run 114' of 8 5/8" surface pipe, cemented with 100 sacks of cement at 112'. Plug down at 11:45 A. M., March 31, 1977. Hole dry and abandoned. Filled hole with mud to 160' and set plug with 25 sacks of cement. Filled hole with mud to 40' and set plug with 10 sacks of cement. 2 sacks in rat hole. Plugging completed at 6:30 A. M., April 6, 1977. Plugging completed by State Plugger, Hugh Scott, McPherson, Ks. 67460.

TOPS:


Measurements taken from K. B.

CERTIFICATE

I, P. E. Plouffe, President of Blackstone Drilling, Inc. do hereby certify that the above and foregoing is a true and correct copy of log on your Orlando Unruh #1, located on the CEL NE/4 NW/4, Section 23-21-2W, McPherson County, Kansas as reflected by the files of Blackstone Drilling, Inc.


P. E. Plouffe, President

Subscribed and sworn to before me a Notary Public in and for McPherson County, Kansas this 7th day of April, 1977.


Johnnie L. Schmidt - Notary Public

