


STATE OF KANSAS
STATE CORPORATION COMMISSION

WELL PLUGGING RECORD

Give All Information Completely
Make Required Affidavit
Mail or Deliver Report to
Conservation Division
State Corporation Comm.
245 North Water
Wichita, KS 67202

Hodgeman County. Sec. 24 Twp. 21S Rge. 24 E/W
Location as "NE/CNW $\frac{1}{4}$ SW $\frac{1}{4}$ " or footage from lines
50' E of C NE SW

Lease Owner Mack Oil Co.
Lease Name Goebel Well No. 1
Office Address 908 Union Center, Wichita, Kansas 67202
Character of Well (Completed as Oil, Gas or Dry Hole)
Dry Hole

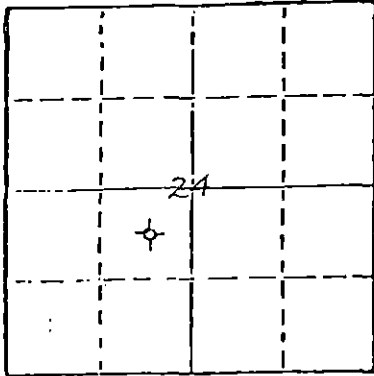

Locate well correctly on above
Section Plot

Date Well completed 3-31 1978
Application for plugging filed 3-31 1978
Application for plugging approved 3-31 1978
Plugging commenced 3-31 1978
Plugging completed 3-31 1978
Reason for abandonment of well or producing formation
commercial quantities of oil not found
If a producing well is abandoned, date of last production
19

Was permission obtained from the Conservation Division or
its agents before plugging was commenced? yes

Name of Conservation Agent who supervised plugging of this well Dwayne Rankin, Great Bend, Ks.
Producing formation _____ Depth to top _____ Bottom _____ Total Depth of Well 4575'
Show depth and thickness of all water, oil and gas formations.

OIL, GAS OR WATER RECORDS

CASING RECORD

FORMATION	CONTENT	FROM	TO	SIZE	PUT IN	PULLED OUT
				8-5/8"	345'	

Describe in detail the manner in which the well was plugged, indicating where the mud fluid
was placed and the method or methods used in introducing it into the hold. If cement or other
plugs were used, state the character of same and depth placed, from _____ feet to
_____ feet for each plug set.

Plug 600' with 70 sx.
300' with 20 sx.
40' with 10 sx.
Rat Hole with 5 sx.

RECEIVED
STATE CORPORATION COMMISSION
APR 05 1978

CONSERVATION DIVISION
Wichita, Kansas


(If additional description is necessary, use BACK of this sheet)

Name of Plugging Contractor Rains & Williamson Oil Co., Inc.

STATE OF Kansas COUNTY OF Sedgwick, ss.
Wilson Rains, President of Rains & Williamson, (employee of owner) or (owner or operator)
of the above-described well, being first duly sworn on oath, says: That I have knowledge of
the facts, statements, and matters herein contained and the log of the above-described well
as filed and that the same are true and correct. So help me God.

(Signature) Wilson Rains
435 Page Court, 220 W. Douglas, Wichita, Kansas
(Address) 67202

SUBSCRIBED AND SWORN TO before me this 3rd day of April, 1978

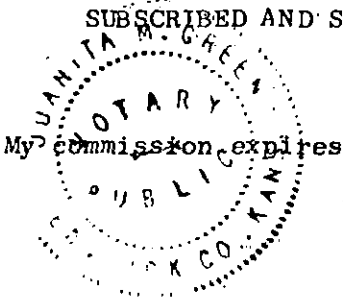

Juanita M. Green
Notary Public.

DRILLER'S LOG

COMPANY: Mack Oil Co.

SEC. 24 T. 21S R. 24W

LOC. 50' E of C NE SW

WELL NAME: Goebel #1

COUNTY: Hodgeman Co., Kansas

RIG NO. 7

TOTAL DEPTH 4575'

ELEVATION

COMMENCED: 3-22-78

COMPLETED: 3-31-78

CONTRACTOR: Rains & Williamson Oil Co., Inc.

CASING RECORD:

SURFACE: 8-5/8" set @ 345' w/220 sx. common, 2% gel, 3% cc.

PRODUCTION: D & A

LOG

(Figures Indicate Bottom of Formations)

Surface Soil, Sand and Shale	170
Shale and Sand	352
Shale and Shells	1080
Sand	1280
Sand and Shale	1615
Anhydrite	1654
Shale	1925
Shale and Lime	2918
Lime, Shale, and Sandy Shale	3120
Shale and Lime	3925
Lime	4095
Lime and Shale	4343
Lime	4448
Lime and Sandy Shale	4555
Lime and Shale	4575
<u>Rotary Total Depth</u>	<u>4575</u>

RECEIVED
STATE CORPORATION COMMISSION
APR 05 1978
CONSERVATION DIVISION
Wichita, Kansas

STATE OF KANSAS)
COUNTY OF SEDGWICK)

SS:

I, Wilson Rains, President of Rains & Williamson Oil Co., Inc.

upon oath state that the above and foregoing is a true and correct copy of the log of the
Goebel #1 well.

Wilson Rains
Wilson Rains

Subscribed and sworn to before me this 3rd day of April, 1978.

My Appointment Expires:
October 4, 1979

Juanita M. Green
Juanita M. Green - Notary Public

