


STATE OF KANSAS
STATE CORPORATION COMMISSION
CONSERVATION DIVISION
P. O. BOX 17027
WICHITA, KANSAS 67217

FORM CP-4

WELL PLUGGING RECORD

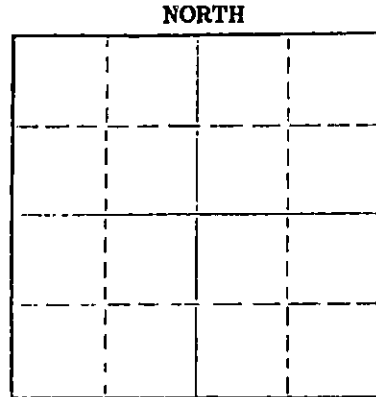

Locate well correctly on above
Section Plot

Hodgeman County. Sec. 32 Twp. 21S Rge. (E)24 (W)
Location as "NE/CNW/SW" or footage from lines C NE NE

Lease Owner PETROLEUM, INC.
Lease Name Dykes Well No. 1
Office Address R.G. Garvey Bldg., 300 W. Douglas, Wichita, Ks.
Character of Well (completed as Oil, Gas or Dry Hole) Dry Hole
Date well completed 9-16 1974
Application for plugging filed 9-16 1974
Application for plugging approved 9-16 1974
Plugging commenced 9-16 1974
Plugging completed 9-16 1974
Reason for abandonment of well or producing formation No commercial quantities of oil or gas encountered.
If a producing well is abandoned, date of last production 19
Was permission obtained from the Conservation Division or its agents before plugging was commenced? Yes

Name of Conservation Agent who supervised plugging of this well Clarence Thomas
Producing formation _____ Depth to top _____ Bottom _____ Total Depth of Well 4618 Feet
Show depth and thickness of all water, oil and gas formations.

OIL, GAS OR WATER RECORDS

CASING RECORD

FORMATION	CONTENT	FROM	TO	SIZE	PUT IN	PULLED OUT
Surface Hole	Water	Surface	566	8-5/8"	558	None

Describe in detail the manner in which the well was plugged, indicating where the mud fluid was placed and the method or methods used in introducing it into the hole. If cement or other plugs were used, state the character of same and depth placed, from _____ feet to _____ feet for each plug set.

Fluid to 850, plug, 70 sx cement;
Fluid to 540', plug, 30 sx cement;
Fluid to 40', plug, 10 sx cement.

(If additional description is necessary, use BACK of this sheet)

Name of Plugging Contractor D N B DRILLING, INC.
Address 701 First Nat'l Bldg., Wichita, Kansas 67202

STATE OF KANSAS COUNTY OF _____ SS.
JAMES L. DONELSON (employee of owner) or (owner or operator) of the above-described well, being first duly sworn on oath, says: That I have knowledge of the facts, statements, and matters herein contained and the log of the above-described well as filed and that the same are true and correct. So help me God.

(Signature) James L. Donelson
701 First Nat'l Bldg., Wichita, Kansas
(Address)

SUBSCRIBED AND SWORN TO before me this 18th day of Sept. 19 74

My commission expires August 25, 1976

Ella Priess
Ella Priess
Notary Public.

RECEIVED
STATE CORPORATION COMMISSION

SEP 20 1974

CONSERVATION DIVISION
Wichita, Kansas

Ella Priess
STATE NOTARY PUBLIC
Sedgwick County, Kansas
My Com. Expires Aug. 25, 1976

DRILLERS' LOG

PETROLEUM, INC.
 No. 1 Dykes
 C NE NE, Sec. 32-21S-24W
 Hodgeman County, Kansas

Elevation: 2413 K.B.

Commenced: 9-8-73
 Completed: 9-16-74

Surface Casing: 558' of
 8-5/8" cemented w/250 sx
 common cement, 4% Gel,
 3% cc.

<u>FORMATION</u>	<u>DEPTH</u>
Surface Hole	0 - 566
Shale	566 - 1045
Blaine Anhydrite	1045 - 1053
Shale & Sand	1053 - 1320
Shale & Red Bed	1320 - 1530
Red Bed	1530 - 1646
Anhydrite	1646 - 1681
Shale	1681 - 2075
Shale & Lime	2075 - 2510
Lime & Shale	2510 - 3105
Shale & Lime	3105 - 3705
Lime & Shale	3705 - 3965
Lime	3965 - 4618 T.D.

I do hereby certify that the foregoing statements are true and correct to the best of my knowledge and belief.

D N B. DRILLING, INC.

James L. Donelson
 JAMES L. DONELSON

STATE OF KANSAS: ss:

Subscribed and sworn to before me, the undersigned, a Notary Public in and for said state, this 18th day of September, 1974.

My Commission Expires:
 August 25, 1976

Ella Priess
 Ella Priess, Notary Public

Ella Priess
 STATE NOTARY PUBLIC
 Sedgwick County, Kansas
 My Com. Expires Aug. 25, 1976

RECEIVED
 STATE CORPORATION COMMISSION

SEP 20 1974

CONSERVATION DIVISION
 Wichita, Kansas