


STATE OF KANSAS  
STATE CORPORATION COMMISSION  
Give All Information Completely  
Make Required Affidavit  
Mail or Deliver Report to:  
Conservation Division  
State Corporation Commission  
212 No. Market  
Wichita, Kansas

WELL PLUGGING RECORD

McPherson County. Sec. 13 Twp. 21S Rge. 2W (XX) (W)

Location as "NE/CNW%SW%" or footage from lines NW NW SE  
Lease Owner Beacon Resources Corporation  
Lease Name Dyck #2 Well No. \_\_\_\_\_  
Office Address 312 Union Center Building, Wichita, Kansas 67202  
Character of Well (completed as Oil, Gas or Dry Hole) Dry Hole  
Date well completed December 17, 19 68  
Application for plugging filed December 16, 19 68  
Application for plugging approved December 16, 19 68  
Plugging commenced 2:00 PM, December 17, 1968 19  
Plugging completed 3:00 PM, December 17, 1968 19  
Reason for abandonment of well or producing formation Dry Hole

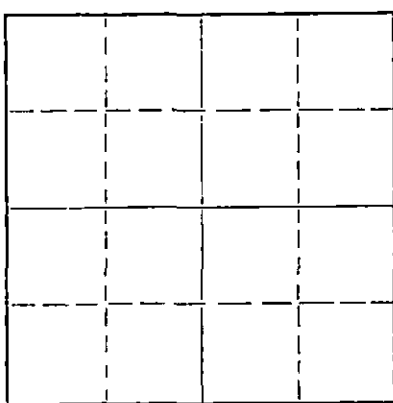

Locate well correctly on above Section Plat

If a producing well is abandoned, date of last production \_\_\_\_\_ 19 \_\_\_\_  
Was permission obtained from the Conservation Division or its agents before plugging was commenced? Yes

Name of Conservation Agent who supervised plugging of this well Gilbert Toman (Hugh Scott on vacation.)  
Producing formation \_\_\_\_\_ Depth to top \_\_\_\_\_ Bottom \_\_\_\_\_ Total Depth of Well 3492' Feet  
Show depth and thickness of all water, oil and gas formations.

OIL, GAS OR WATER RECORDS

CASING RECORD

FORMATION	CONTENT	FROM	TO	SIZE	PUT IN	PULLED OUT
				8 5/8	209'	None

Describe in detail the manner in which the well was plugged, indicating where the mud fluid was placed and the method or methods used in introducing it into the hole. If cement or other plugs were used, state the character of same and depth placed, from \_\_\_\_\_ feet to \_\_\_\_\_ feet for each plug set.

Heavy mud to 200' with Howco Plug and 1/4 sack Hulls and 25 sacks Regular Cement. Heavy mud to 40' with Howco Plug and 1/4 sack Hulls and 10 sacks Regular Cement to Surface. Also 2 sacks in rathole.

RECEIVED  
STATE CORPORATION COMMISSION  
FEB 12 1969  
CONSERVATION DIVISION  
Wichita, Kansas

(If additional description is necessary, use BACK of this sheet)

Name of Plugging Contractor Sterling Drilling Company  
Address P. O. Box 129, Sterling, Kansas 67579

STATE OF KANSAS, COUNTY OF RICE, ss.  
F. A. Wuellner (employee of owner) or (owner or operator) of the above-described well, being first duly sworn on oath, says: That I have knowledge of the facts, statements, and matters herein contained and the log of the above-described well as filed and that the same are true and correct. So help me God.

(Signature) [Signature] STERLING DRILLING COMPANY  
F. A. Wuellner, Secretary  
P. O. Box 129, Sterling, Kansas 67579  
(Address)

SUBSCRIBED AND SWORN TO before me this 31st day of December, 1968

My commission expires BERNARD LAUDERMILK, Notary Public  
Commission Expires January 22, 1970

[Signature]  
Bernard Laudermilk, Notary Public.

XERO COPY

XERO COPY

XERO COPY

XERO COPY

15.113.20059.0000

STERLING DRILLING COMPANY  
P. O. Box 129  
Sterling, Kansas 67579

WELL LOG ----- DYCK #2  
LOCATED: NW NW SE, Sec. 13-21S-2W, McPherson County, Kansas

OWNER: Beacon Resources Corporation  
ROTARY DRILLING CONTRACTOR: Sterling Drilling Company

COMMENCED: December 9, 1968  
COMPLETED: December 17, 1968

TOTAL DEPTH: 3492'

<u>LOG</u>		<u>CASING RECORD</u>
0 -	35 Clay	Ran 11 joints 8 5/8" 28# used Lapweld Casing. 209' casing set @ 221' K.B. Cemented with 200 sacks Regular with 2% gal, 3% cc. Plug down @ 12:30 PM, 12-10-68.
35 -	55 Gravel	
55 -	221 Shale	
221 -	2980 Lime and Shale	
2980 -	3492 Lime	Plugged.

RECEIVED  
STATE CORPORATION COMMISSION  
JAN 2 1969  
CONSERVATION DIVISION  
Wichita, Kansas