


WELL PLUGGING RECORD

Give All Information Completely
Make Required Affidavit
Mail or Deliver Report to:
Conservation Division
State Corporation Commission
800 Rising Building
Wichita, Kansas

Pawnee County. Sec. 11 Twp. 21 Rge. (E) 16 (W)
Location as "NE/CNW $\frac{1}{4}$ SW $\frac{1}{4}$ " or footage from lines C NE NW SW
Lease Owner Gulf Oil Corporation
Lease Name Earl J. Bowman Well No. 2
Office Address P.O. Box 661, Tulsa 2, Oklahoma
Character of Well (completed as Oil, Gas or Dry Hole) Dry Hole
Date well completed Sept. 14, 1950
Application for plugging filed Jan. 8, 1951
Application for plugging approved Jan. 10, 1951
Plugging commenced Jan. 22, 1951
Plugging completed Jan. 24, 1951
Reason for abandonment of well or producing formation Dry Hole

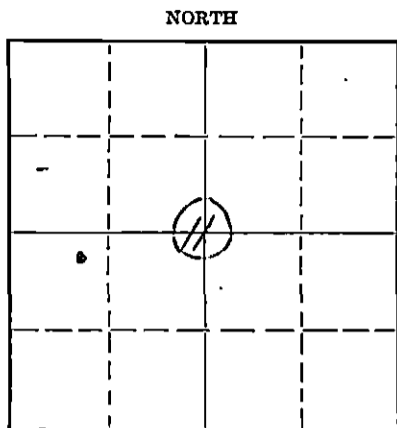

Locate well correctly on above Section Plat

If a producing well is abandoned, date of last production Dry Hole 19...
Was permission obtained from the Conservation Division or its agents before plugging was commenced? Yes

Name of Conservation Agent who supervised plugging of this well Mr. C. D. Stough, Box 207, Great Bend, Kansas
Producing formation Depth to top Bottom Total Depth of Well 3823 Feet
Show depth and thickness of all water, oil and gas formations.

OIL, GAS OR WATER RECORDS

CASING RECORD

Formation	Content	From	To	Size	Put In	Pulled Out
				10- $\frac{3}{8}$ "	34'	None
				8- $\frac{7}{8}$ "	1001'	None
				5 $\frac{1}{2}$ "	3790 $\frac{1}{2}$ '	3081'

Describe in detail the manner in which the well was plugged, indicating where the mud fluid was placed and the method or methods used in introducing it into the hole. If cement or other plugs were used, state the character of same and depth placed, from feet to feet for each plug set.
Ran bailer, would not go below 3650'. Bridged hole with rock at 3456' and dumped 5 sacks cement on bridge. (Procedure approved by Mr. Stough, State Plugging Inspector).
Mudded hole to 250', set rock bridge 250' to 240' and dumped 15 sacks cement at 240'.
Mudded hole to 40' of surface and capped with 10 sacks cement.

RECEIVED
STATE CORPORATION COMMISSION
JAN 29 1951
CONSERVATION DIVISION
Wichita, Kansas

(If additional description is necessary, use BACK of this sheet)
Correspondence regarding this well should be addressed to S. G. Sanderson
Address P.O. Box 661, Tulsa 2, Oklahoma

STATE OF Kansas, COUNTY OF Rice, ss.
H. H. Wright (employee of owner) or (owner/operator) of the above-described well, being first duly sworn on oath, says: That I have knowledge of the facts, statements, and matters herein contained and the log of the above-described well as filed and that the same are true and correct. So help me God.

(Signature) *H. H. Wright*
P. O. Box 554, Chase, Kansas (Address)

Subscribed and sworn to before me this 26th day of January, 1951
M. Council Notary Public

My commission expires April 14, 1952

PLUGGING
FILE SEC 11 T 21 R 16
BOOK PAGE 54 LINE 19

