


WELL PLUGGING RECORD

Give All Information Completely
Make Required Affidavit
Mail or Deliver Report to:
Conservation Division
State Corporation Commission
800 Bittling Building
Wichita, Kansas

NORTH

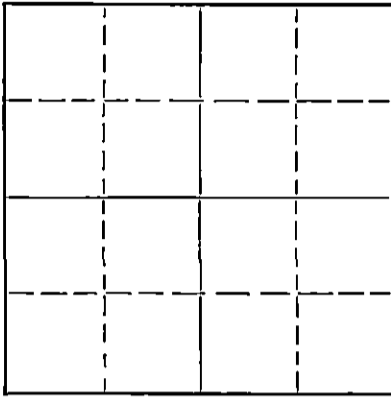

Locate well correctly on above
Section Flat

Stafford County. Sec. 25 Twp. 21 Rge. 14 ~~Box~~ (W)
Location as "NE/CNW $\frac{1}{4}$ SW $\frac{1}{4}$ " or footage from lines NE NE NW
Lease Owner Graham-Messman-Rinehart Oil Company
Lease Name Russell Well No. 1
Office Address 204 N. Market, Wichita, Kansas
Character of Well (completed as Oil, Gas or Dry Hole) Dry Hole
Date well completed August 29 19 51
Application for plugging filed September 6 19 51
Application for plugging approved August 30 19 51
Plugging commenced August 31 19 51
Plugging completed August 31 19 51
Reason for abandonment of well or producing formation Dry

If a producing well is abandoned, date of last production 19
Was permission obtained from the Conservation Division or its agents before plugging was commenced? Yes

Name of Conservation Agent who supervised plugging of this well C. D. Stough
Producing formation _____ Depth to top _____ Bottom _____ Total Depth of Well 3798 Feet
Show depth and thickness of all water, oil and gas formations.

OIL, GAS OR WATER RECORDS

CASING RECORD

Formation	Content	From	To	Size	Put In	Pulled Out
				8 5/8"	223'	None

Describe in detail the manner in which the well was plugged, indicating where the mud fluid was placed and the method or methods used in introducing it into the hole. If cement or other plugs were used, state the character of same and depth placed, from _____ feet to _____ feet for each plug set.

Set bottom plug at 215'
Cemented with 15 sx to drill pipe
Set top plug at 40' - bridged to hold Kelly
Cemented with 10 sx
Mud to surface

STATE CORPORATION COMMISSION
SEP 28 1951
CONSERVATION DIVISION
Wichita, Kansas

(If additional description is necessary, use BACK of this sheet)
Correspondence regarding this well should be addressed to Graham-Messman-Rinehart Oil Company
Address 204 N. Market, Wichita, Kansas

STATE OF Kansas, COUNTY OF Sedgwick, ss.
J. A. Gilliland (employee of owner) or (owner or operator) of the above-described well,
being first duly sworn on oath, says: That I have knowledge of the facts, statements, and matters herein contained and the log of the above-described well as filed and that the same are true and correct. So help me God.
(Signature) J. A. Gilliland
204 N. Market, Wichita, Kansas
(Address)

SUBSCRIBED AND SWORN TO before me this 6th day of September, 19 51

Oliver Carter
Notary Public.

My commission expires March 21, 1955

PLUGGING
FILE SEC. 25 T. 21 R. 14
BOOK PAGE 107 LINE 25

RUSSELL #1

Casing Record:
8-5/8" - 223'

Company: Graham-Messman-Rinehart Oil Co.
Contractor: Aylward Drilling Company

Description:
NE $\frac{1}{4}$ NE $\frac{1}{4}$ NW $\frac{1}{4}$ of
Sec. 25-21S-14W,
Stafford Co., Kansas

Commenced: August 18, 1951
Completed: August 30, 1951

D. & A.

<u>Formation</u>	<u>From</u>	<u>To</u>	<u>Remarks</u>
Surface Sanc	0	45	
Sand & Clay	45	190	
Blue Shale	190	250	Set 8-5/8" @ 223' and
Sand	250	345	cemented w/175 sax.
Red Bed & Shells	345	375	
Red Bed & Shale	375	500	
Sand & Shale	500	820	
Anhydrite	820	845	
Shale & Sand	845	850	
Shale & Shells	850	1330	
Salt	1330	1550	
Shale	1550	1595	
Sand	1595	1605	
Shale	1605	1625	
Lime	1625	2000	
Lime & Shale	2000	2265	
Shale	2265	2335	
Shale & Lime	2335	2500	
Shale & Shells	2500	2645	
Shale	2645	2760	
Lime & Shale	2760	3212	
Lime	3212	3262	
Lime & Shale	3262	3360	
Shale	3360	3400	
Lime	3400	3436	
Lime & Shale	3436	3487	
Lime	3487	3655	
Lime & Chert	3655	3692	
Conglomerate & Cherty Lime	3692	3733	
Shale	3733	3771	
Lime Arb.	3771	3777	
Lime	3777	3798	

RECEIVED




I certify that this is a true and correct copy of the above log.

[Signature]

Subscribed and sworn to before me this 5 day of September, 1951

[Signature]
Notary Public

My Commission Expires

April 25, 1953

PLUGGING
FILE SEC 25 T 21 R 14W
BOOK PAGE 127 LINE 25