


WELL PLUGGING RECORD

Give All Information Completely
Make Required Affidavit
Mail or Deliver Report to:
Conservation Division
State Corporation Commission
211 No. Broadway
Wichita, Kansas

Stafford County, Sec. 25 Twp. 21 Rge. 14 (E) X(W)
Location as "NE/CNW/SE/SW" or footage from lines _____
Lease Owner William Cohen & Co.
Lease Name Russell Well No. 1
Office Address 245 Patton Wichita 8 Kansas
Character of Well (completed as Oil, Gas or Dry Hole) Oil
Date well completed _____ 19____
Application for plugging filed _____ 19____
Application for plugging approved _____ 19____
Plugging commenced 4 / 19 19 65
Plugging completed 4 / 29 19____
Reason for abandonment of well or producing formation _____

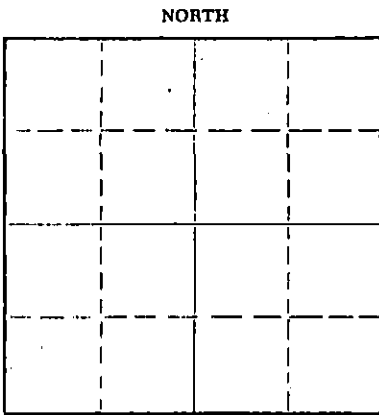

Locate well correctly on above
Section Plat

If a producing well is abandoned, date of last production _____ 19____
Was permission obtained from the Conservation Division or its agents before plugging was commenced? Yes

Name of Conservation Agent who supervised plugging of this well Archie Elving
Producing formation _____ Depth to top _____ Bottom _____ Total Depth of Well 3792 Feet
Show depth and thickness of all water, oil and gas formations.

OIL, GAS OR WATER RECORDS

CASING RECORD

FORMATION	CONTENT	FROM	TO	SIZE	PUT IN	PULLED OUT
				8 5/8	209'	
				5 1/2	3792'	3189'

Describe in detail the manner in which the well was plugged, indicating where the mud fluid was placed and the method or methods used in introducing it into the hole. If cement or other plugs were used, state the character of same and depth placed, from _____ feet to _____ feet for each plug set.

Set plug at 3540' and run 5 sacks of cement from 3540' to 3510'
Set plug at 209' rock and sand from 209' to 199' run 25 sacks of cement
from 199' to 124' mudded from 124' to 30' and run 10 sacks of cement
from 30' to base of cellar.

RECEIVED
STATE CORPORATION COMMISSION

MAY 4 1965

CONSERVATION DIVISION
Wichita, Kansas

(If additional description is necessary, use BACK of this sheet)

Name of Plugging Contractor GLENN & SMITH PIPE PULLING CO.
Address Box 156 Ellinwood, Kansas

STATE OF Kansas, COUNTY OF Sedgewick, ss.
William Cohen & Co. (employee of owner) or (owner or operator) of the above-described well, being first duly sworn on oath, says: That I have knowledge of the facts, statements, and matters herein contained and the log of the above-described well as filed and that the same are true and correct. So help me God.

(Signature) William Cohen & Co.
By Wm. Cohen - 245 Patton
(Address)

SUBSCRIBED AND SWORN to before me this 2 day of May, 1965

My commission expires August 30, 1967
Vergenia E. Martin
Notary Public.

WELL LOG BUREAU - KANSAS GEOLOGICAL SOCIETY
 508 E. Murdock Wichita, Kansas

COPY


15.185.00605.0000

Company - PETROLEUM, INC.
 Farm - Russell No. 1

SEC. 25 T. 21 R. 14W
 SW SE NW

Total Depth. 3772
 Comm. 5-10-50 Comp. 5-21-50
 Shot or Treated.
 Contractor. Carvoy Oil
 Issued. 7-22-50

County. Stafford
 KANSAS

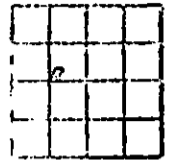

Elevation. _____

Production. 256 bbls. oil

Figures Indicate Bottom of Formations.

sand	175
shale & shells	205
sand	310
redbed	820
anhydrite	855
shale & shells	1510
shale & limo	1630
limo	1775
limo & shalo	2080
shale	2695
shale & shells	2810
limo & shalo	2950
limo	3060
limo & shalo	3190
limo	3215
limo & shalo	3345
limo	3440
conglomerate	3654
viola chert	3700
shalo	3703
limo	3772
Total depth	

Tops:	
Anhydrite	830
Topoka	2396
Hoebner	3263
Toronto	3285
B. O.	3302
Brown limo	3385
Lansing-Kansas City	3396
Base Kansas City	3612
P. B. C.	3635
Viola	3754
Simpson	3705
Arbuckle	3752

Remarks:
 3522-34, DST #1 3510-30, rec.
 65' heavily oil cut mud with
 free oil.
 3542-46; 3556-60; 3577-81.
 DST #2 3575-90, rec. 2405' gas
 & 595' clean gassy oil.
 3595-3410
 DST #3 3755-72, rec. 2200'
 salt water.

RECEIVED
 STATE CORPORATION COMMISSION
 MAY 4 1965
 CONSERVATION DIVISION
 Wichita, Kansas