


STATE OF KANSAS
STATE CORPORATION COMMISSION

WELL PLUGGING RECORD

Give All Information Completely
Make Required Affidavit
Mail or Deliver Report to:
Conservation Division
State Corporation Commission
800 Bitting Building
Wichita, Kansas

Stafford County. Sec. 27 Twp. 21S Rge. 12W (E) (W)

Location as "NE/CNW/SW" or footage from lines. NE NE SE
Lease Owner Fred B. Anschutz
Lease Name Shumway Well No. 1
Office Address 1019 Central Bldg., Wichita 2, Kansas
Character of Well (completed as Oil, Gas or Dry Hole) Oil
Date well completed 11-9-1955
Application for plugging filed 11-29-1955
Application for plugging approved 5-7-1956
Plugging commenced 5-13-1956
Plugging completed 5-24-1956
Reason for abandonment of well or producing formation Depleted

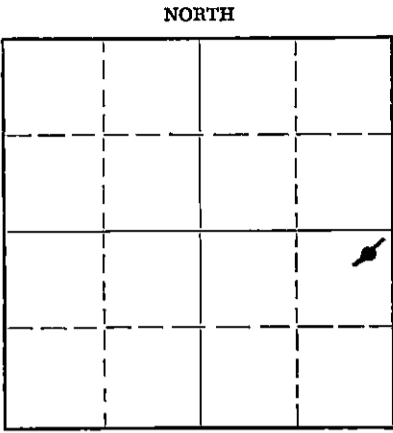

Locate well correctly on above Section Plat

If a producing well is abandoned, date of last production 5-1-1956
Was permission obtained from the Conservation Division or its agents before plugging was commenced? Yes

Name of Conservation Agent who supervised plugging of this well B. M. Brundage
Producing formation Arbuckle Depth to top 3610 Bottom 3660 Total Depth of Well 3660 Feet
Show depth and thickness of all water, oil and gas formations.

OIL, GAS OR WATER RECORDS

CASING RECORD

FORMATION	CONTENT	FROM	TO	SIZE	PUT IN	PULLED OUT
Arbuckle	oil & water	3613	3618	5-1/2"	3660	2807
		3628	3630			
				8-5/8"	302	None

Describe in detail the manner in which the well was plugged, indicating where the mud fluid was placed and the method or methods used in introducing it into the hole. If cement or other plugs were used, state the character of same and depth placed, from _____ feet to _____ feet for each plug set.

3660 to 3595 ft.	Filled with sand
3595 to 3570 ft.	5 sacks cement
3570 to 250 ft.	Mudded
250 to 240 ft.	Rock bridge
240 to 180 ft.	20 sacks cement
180 to 35 ft.	Mud.
35 ft. to cellar	10 sacks cement

(If additional description is necessary, use BACK of this sheet)

Name of Plugging Contractor R & S Pipe Pulling Co.
Address Box 192, Ellinwood, Kansas

STATE OF KANSAS, COUNTY OF SEDGWICK, ss. John W. Ritchey (employee of owner) or (owner or operator) Agent of the above-described well, being first duly sworn on oath, says: That I have knowledge of the facts, statements, and matters herein contained and the log of the above-described well as filed and that the same are true and correct. So help me God.

(Signature) John W. Ritchey
1019 Central Building, Wichita 2, Kansas
(Address)

SUBSCRIBED AND SWORN to before me this 11th day of June, 1956.

My commission expires May 21, 1960. Ernie Spencer Notary Public.

PLUGGING
FILE SEC. 27 T. 21 R. 12W
BOOK PAGE 59 LINE 33

6-14-1956

WELL LOG BUREAU—KANSAS GEOLOGICAL SOCIETY
508 East Murdock, Wichita, Kansas


15.185.00308.0000

Company- FRED B. ANSCHUTZ
Farm- Shumway No. 1

SEC. 27 T. 21 R. 12W
NE NE SE

Total Depth. 3660'
Comm. 11-9-55 Comp. 1-6-56
Shot or Treated.
Contractor.
Issued. 3-31-56

County Stafford
KANSAS

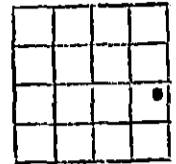

CASING:
8 5/8" 302' cem w/225 sx

Elevation. 1846' RB

Production. 52 BOPD

Figures indicate Bottom of Formations.

sand	175
shale & red rock	308
red bed & shale	650
shale & shells	850
red bed & shale	925
anhydrite	960
shale	1140
salt & shale	1250
shale, salt & shells	1500
shale, lime & sandy lime	1555
lime & shale	1930
shale & lime	2060
lime & shale	2185
shale & lime	2380
shale	2585
shale & lime	2845
lime	2950
lime & shale	3115
shale & lime	3279
lime	3475
lime & shale	3529
shale, lime & chert	3568
lime & shale	3610
Arbuckle lime	3660 RTD
Total Depth	

Tops: Scout	
Heebner	3124
Toronto	3145
Brown Lime	3255
Lansing	3272
Conglomerate	3536
Viola	3543
Simpson	3565
Arbuckle	3602

PLUGGING
FILE SEC. 27 T. 21 R. 12W
BOOK PAGE 59 LINE 33