

STATE OF KANSAS
STATE CORPORATION COMMISSION

WELL PLUGGING RECORD

Give All Information Completely
Make Required Affidavit
Mail or Deliver Report to:
Conservation Division
State Corporation Commission
800 Bittling Building
Wichita, Kansas

OR
FORMATION PLUGGING RECORD

Strike out upper line
when reporting plugging
of formations.

Stafford County. Sec. 27 Twp. 21 Rge. 12 (E) (W)

Location as "NE $\frac{1}{4}$ NW $\frac{1}{4}$ SW $\frac{1}{4}$ " or footage from lines SE SW

Lease Owner B & R Drilling Co.

Lease Name Freeman Well No. 1

Office Address Russell, Ks.

Character of Well (completed as Oil, Gas or Dry Hole) Dry Hole

Date well completed 4/18/46 19

Application for plugging filed 4/17/46 19

Application for plugging approved 4/17/46 19

Plugging commenced 4/17/46 19

Plugging completed 4/17/46 19

Reason for abandonment of well or producing formation Dry Hole

If a producing well is abandoned, date of last production 19

Was permission obtained from the Conservation Division or its agents before plugging was commenced? Yes

NORTH

Locate well correctly on above Section Plat

Name of Conservation Agent who supervised plugging of this well Durkee

Producing formation Depth to top Bottom Total Depth of Well 3738 Feet

Show depth and thickness of all water, oil and gas formations.

OIL, GAS OR WATER RECORDS

CASING RECORD

Formation	Content	From	To	Size	Put In	Pulled Out
				8 5/8"	290'	None

Describe in detail the manner in which the well was plugged, indicating where the mud fluid was placed and the method or methods used in introducing it into the hold. If cement or other plugs were used, state the character of same and depth placed, from.....feet to.....feet for each plug set.

Fill hole with mud - plug at 285' - Cement with 15 sacks - Fill with mud to 35' - Plug and 10 sacks of cement.

PLUGGING
FILE SEC. 27-21R12W
BOOK PAGE 54 LINE 44

STATE CORPORATION COMMISSION
MAY 23 1946

(If additional description is necessary, use BACK of this sheet)

Correspondence regarding this well should be addressed to B & R Drilling Co.
Address Russell, Ks.

STATE OF KANSAS, COUNTY OF RUSSELL, ss.
C. L. Roberts (employee of owner) or (owner or operator) of the above-described well,

being first duly sworn on oath, says: That I have knowledge of the facts, statements, and matters herein contained and the log of the above-described well as filed and that the same are true and correct. So help me God.

(Signature) *C. L. Roberts*

Russell, Ks.
(Address)

SUBSCRIBED AND SWORN to before me this 17th day of May, 19 46

Genevieve Poole

Notary Public.

My commission expires 7/2/49

B & R Drilling Company
Freeman #1


Sec. 27 Twp. 21 Rge. 12
County: Stafford, Kansas

Total Depth: 3738
Comm: 5/1/46 Comp: 5/18/46

Casing
14 Jts. 8 5/8" Set at 290'

Cement
275 Sacks

Formation:	Depth:
Sand	25'
Shale	60
Sand, Shale, Shells	195
Red Bed & Sand	270
Shale & Shells	379
Red Rock, Shale & Shells	750
Red Bed & Shells	765
Anhydrite & Shale	795
Shale & Shells	1325
Salt	1420
Salt, Shale, & Shells	1490
Shale & Shells	1515
Lime & Shale	1555
Anhydrite	1622
Lime & Shale	1755
Lime	1820
Sandy Lime & Shale	1895
Shale & Lime	2605
Lime	2640
Lime & Shale	2880
Lime, Cherty	2930
Lime	2945
Cherty Lime, Rough.	2960
Lime	2985
Chert & Lime	2998
Sandy Lime	3025
Lime & Shale	3070
Lime, Cherty	3088
Lime, Cherty, Rough.	3096
Lime	3102
Lime, Cherty	3140
Lime & Shale	3296
Lime, K.C.	3315
Lime	3533
Lime & Shale	3543
Shale Conglomerate	3735
Cherty Congl.	3738

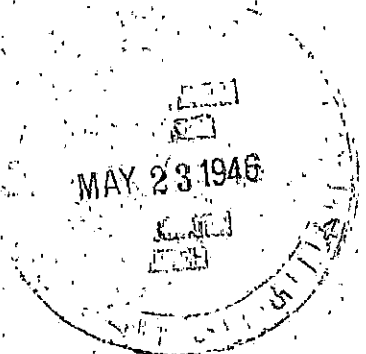

STATE OF KANSAS)
) SS
RUSSELL COUNTY)

PLUGGIN 3738
FILE NO. 27 21 122
ECON PAGE 54

I hereby certify that the above information is true and correct to the best of my knowledge.

Clara Hummel

Subscribed and sworn to before me this 18th day of May, 1946.

My Comm. Expires 7/2/49

Jenewise Poole
Notary Public