


STATE OF KANSAS  
STATE CORPORATION COMMISSION

Give All Information Completely  
Make Required Affidavit  
Mail or Deliver Report to:  
Conservation Division  
State Corporation Commission  
211 No. Broadway  
Wichita, Kansas

WELL PLUGGING RECORD

Stafford County, Sec. 33 Twp. 21 Rge. 14 (X) (W)

Location as "NE/CNW%SW%" or footage from lines SW SW NW  
Lease Owner Buick Drilling Inc., et al  
Lease Name Cox Well No. 1  
Office Address P. O. Box 331 - St. John, Kansas  
Character of Well (completed as Oil, Gas or Dry Hole) Dry Hole  
Date well completed February 27, 19 57  
Application for plugging filed February 27, 19 57  
Application for plugging approved February 27, 19 57  
Plugging commenced February 27, 19 57  
Plugging completed February 27, 19 57  
Reason for abandonment of well or producing formation Dry

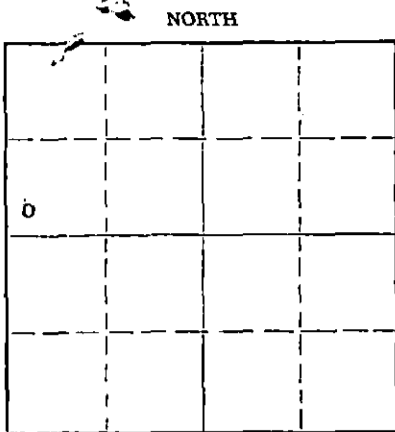

Locate well correctly on above  
Section Plat

If a producing well is abandoned, date of last production \_\_\_\_\_ 19\_\_\_\_  
Was permission obtained from the Conservation Division or its agents before plugging was commenced? yes

Name of Conservation Agent who supervised plugging of this well R. M. Brundege  
Producing formation \_\_\_\_\_ Depth to top \_\_\_\_\_ Bottom \_\_\_\_\_ Total Depth of Well 3892 Feet  
Show depth and thickness of all water, oil and gas formations.

OIL, GAS OR WATER RECORDS

CASING RECORD

FORMATION	CONTENT	FROM	TO	SIZE	PUT IN	PULLED OUT
		0	283'	8 5/8"	283'	0

Describe in detail the manner in which the well was plugged, indicating where the mud fluid was placed and the method or methods used in introducing it into the hole. If cement or other plugs were used, state the character of same and depth placed, from \_\_\_\_\_ feet to \_\_\_\_\_ feet for each plug set.

From 3892' back to 240' with heavy rotary mud. 1/3 sack of hulls. Set Howco plug with 20 sacks cement placed through drill pipe. Heavy rotary mud back to 20 feet. 1/3 sack hulls. One Howco plug set with five sacks cement.

(If additional description is necessary, use BACK of this sheet)

Name of Plugging Contractor Buick Drilling Inc.  
Address P. O. Box 331 - St. John, Kansas

STATE OF Kansas, COUNTY OF Stafford, ss.  
H. R. Buick (employee of owner) or (owner or operator) of the above-described well, being first duly sworn on oath, says: That I have knowledge of the facts, statements, and matters herein contained and the log of the above-described well as filed and that the same are true and correct. So help me God.

(Signature) [Signature]  
P. O. Box 331 - St. John, Kansas  
(Address)

SUBSCRIBED AND SWORN TO before me this 4th day of March, 19 57

My commission expires December 26, 1959.

[Signature] Notary Public.  
STATE CORPORATION COMMISSION

PLUGGING  
FILE SEC. 33 T. 21 R. 14W  
BOOK PAGE 144 LINE 18

MAR 17 - 1957  
CONSERVATION DIVISION  
WICHITA, KANSAS  
3-7-1957

## DRILLERS LOG

Cox #1  
 Commenced R.D.: 2-11-57  
 Completed R.D.: 2-27-57  
 Total Depth: 3892'  
 Casing Record: 283' of 8 5/8"

SW SW NW  
 Sec. 33-21-14W, Stafford Co.  
 Elevation: 1944 D.F.  
 Initial Prod.: Arbuckle  
 Contractor: Buick Drilling Inc.

STRATA	DEPTH
Surface clay, sand and gravel	0 - 245
Blue shale and clay	245 - 275
White clay	275 - 283
Shale	283 - 320
Red bed	320 - 440
Red bed and shale	440 - 790
Red bed	790 - 873
Anhydrite	873 - 915
Shale and shells	915 - 1640
Lime and shale	1640 - 3250
Lime	3250 - 3332
Shale and lime	3332 - 3445
Lime	3445 - 3745
Shale and chert	3745 - 3835
Shale	3835 - 3867
Shale and chert	3867 - 3892 T.D.

I hereby certify the above a true and correct drilling log as reflected by the drilling reports of the Buick Drilling Inc.

BUICK DRILLING INC.

*H. R. Buick*  
 H. R. Buick, President

Signed and sworn to in my presence this 4th day of March, 1957, by H. R. Buick, President of the Buick Drilling Inc.

*Roberta Hoque*  
 Notary Public

My commission expires December 26, 1959.

PLUGGING			
FILE	SEC. 33	T. 21	R. 14W
BOOK	PAGE 144	LINE 18	

RECEIVED  
 STATE CORPORATION COMMISSION

MAR 7 - 1957

CONSERVATION DIVISION  
