


Give All Information Completely  
Make Required Affidavit  
Mail or Deliver Report to:  
Conservation Division  
State Corporation Commission  
212 North Market, Insurance Bldg.  
Wichita, Kansas

WELL PLUGGING RECORD

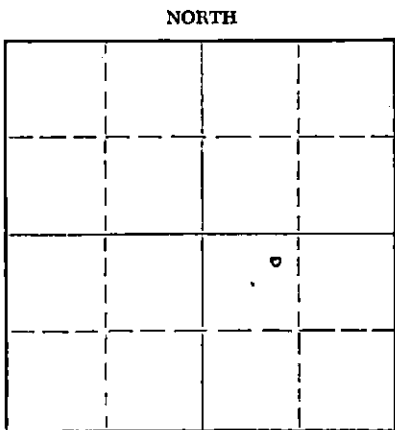

Locate well correctly on above Section Plat

Stafford County, Sec. 33 Twp. 21S Rge. 14 (E) W (W)  
Location as "NE/CNW%SW%" or footage from lines NE NW SE  
Lease Owner Hilton Drilling Company et al  
Lease Name Krampe Well No. 2  
Office Address 925 Patton Road, Great Bend, Kansas  
Character of Well (completed as Oil, Gas or Dry Hole) Dry Hole  
Date well completed November 29 1959  
Application for plugging filed November 29 1959  
Application for plugging approved November 29 1959  
Plugging commenced November 29 1959  
Plugging completed November 29 1959  
Reason for abandonment of well or producing formation Dry Hole

If a producing well is abandoned, date of last production 19  
Was permission obtained from the Conservation Division or its agents before plugging was commenced? Yes

Name of Conservation Agent who supervised plugging of this well Lew Brock, Great Bend, Kansas  
Producing formation \_\_\_\_\_ Depth to top \_\_\_\_\_ Bottom \_\_\_\_\_ Total Depth of Well 3794 Feet  
Show depth and thickness of all water, oil and gas formations.

OIL, GAS OR WATER RECORDS

CASING RECORD

FORMATION	CONTENT	FROM	TO	SIZE	PUT IN	PULLED OUT
				8 5/8"	268'	None

Describe in detail the manner in which the well was plugged, indicating where the mud fluid was placed and the method or methods used in introducing it into the hole. If cement or other plugs were used, state the character of same and depth placed, from \_\_\_\_\_ feet to \_\_\_\_\_ feet for each plug set.

Cemented bottom plug @ 250' with 20 sacks of cement

Cemented top plug @ 35' with 10 sacks of cement

Job completed at 11:45 p. m.

**RECEIVED**  
STATE CORPORATION COMMISSION  
DEC 8 1959  
CONSERVATION DIVISION  
Wichita, Kansas

(If additional description is necessary, use BACK of this sheet)  
Name of Plugging Contractor Hilton Drilling Company, Inc.  
Address 925 Patton Road, Great Bend, Kansas

STATE OF KANSAS, COUNTY OF BARTON, ss.  
Dan H. Cook (employee of owner) or (~~owner or operator~~) of the above-described well, being first duly sworn on oath, says: That I have knowledge of the facts, statements, and matters herein contained and the log of the above-described well as filed and that the same are true and correct. So help me God.

(Signature) Dan H. Cook  
925 Patton Road, Great Bend, Kansas  
(Address)

SUBSCRIBED AND SWORN TO before me this 4th day of December, 1959

Carmen Reinhardt Leiker  
Carmen Reinhardt Leiker Notary Public.

My commission expires January 26, 1963



## DRILLER'S LOG

COMPANY: Hilton Drilling Company, Inc. LOCATION: NE NW SE  
 Sec. 33-21S-14W  
 CONTRACTOR: Hilton Drilling Company, Inc. Stafford County, Kansas  
 FARM NAME: Krampe #2 ELEVATION: 1944 KB  
 COMMENCED: November 18, 1959 CASING USED: 8 5/8" @ 268' with  
 275 sacks  
 COMPLETED: November 29, 1959

Sand & Clay	240
Shale	300
Sand	320
Shale, Shells & Red Bed	855
Anhydrite	880
Shale & Shells	1,610
Shale & Lime	1,925
Lime	2,015
Lime & Shale	2,565
Shale	2,730
Lime & Shale	3,015
Lime	3,165
Lime & Shale	3,220
Lime	3,280
Lime & Shale	3,375
Shale	3,418
Lime	3,680
Lime & Chert	3,745
Chert & Shale	3,773
Lime	3,794 TD

RECEIVED  
 STATE CONSERVATION COMMISSION  
 DEC 8 1959  
 CONSERVATION DIVISION  
 Wichita, Kansas


STATE OF KANSAS )  
 ) SS  
 COUNTY OF BARTON )

I, the undersigned, being duly sworn on oath, state that the above statement and log are true and a correct record and log of the well drilled at the location above described.

HILTON DRILLING COMPANY, INC.

  
 Dan H. Cook - Vice President

Subscribed and sworn to before me this 4th day of December, 1959

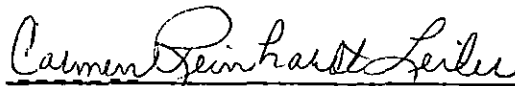  
 Carmen Reinhardt Leiker,  
 Notary Public

My Commission expires January 26, 1963.