

STATE OF KANSAS
STATE CORPORATION COMMISSION


Give All Information Completely
Make Required Affidavit
Mail or Deliver Report to:
Conservation Division
State Corporation Commission
211 No. Broadway
Wichita, Kansas

WELL PLUGGING RECORD

Kearny County, Sec. 20 Twp. 21S Rge. 35 (E) W (W)

Location as "NE/CNW/SW" or footage from lines C NW/4 SW/4
Lease Owner Phillips Petroleum Company
Lease Name Specht "B" Well No. 1
Office Address Box 358, Borger, Texas 79007
Character of Well (completed as Oil, Gas or Dry Hole) Lost Hole
Date well completed _____ 19____
Application for plugging filed _____ * 19____
Application for plugging approved _____ 12 - 10 19 67
Plugging commenced _____ 12 - 10 19 67
Plugging completed _____ 12 - 10 19 67
Reason for abandonment of well or producing formation _____ Lost hole

NORTH

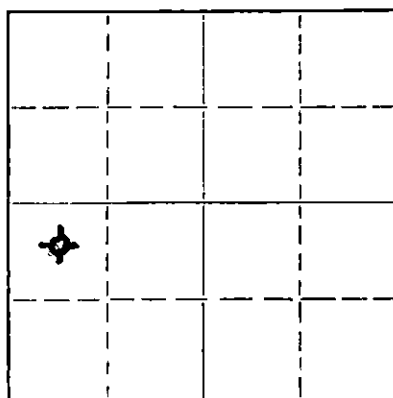

Locate well correctly on above
Section Plat

If a producing well is abandoned, date of last production _____ 19____
Was permission obtained from the Conservation Division or its agents before plugging was commenced? _____ Yes

Name of Conservation Agent who supervised plugging of this well Edgar J. Eves, Sublette, Kansas
Producing formation None Depth to top _____ Bottom _____ Total Depth of Well 4159 Feet
Show depth and thickness of all water, oil and gas formations.

OIL, GAS OR WATER RECORDS

CASING RECORD

FORMATION	CONTENT	FROM	TO	SIZE	PUT IN	PULLED OUT
No oil or gas producing	formation			8 5/8"	1260'	0
					None	

Describe in detail the manner in which the well was plugged, indicating where the mud fluid was placed and the method or methods used in introducing it into the hole. If cement or other plugs were used, state the character of same and depth placed, from _____ feet to _____ feet for each plug set.

Drilled to 4159' and twisted off drill pipe at 1015'. Backed off with Dia Log and left 411' drill pipe in hole. Washed over and recovered 93' of drill pipe. Spotted 80 sacks cement 3642 - 3842' and attempted to kickoff. Could not get out of hole. Spotted 50 sacks cement and 2% CaCl 3310 - 3550', 35 sacks Pozmix cement 600 - 700', and 15 sacks Pozmix cement 0 - 30'. Skidded rig 100' south to Specht "B" No. 1A location.

RECEIVED
STATE CORPORATION COMMISSION

DEC 20 1967

CONSERVATION DIVISION
Wichita, Kansas

(If additional description is necessary, use BACK of this sheet)

Name of Plugging Contractor Halliburton Company
Address Liberal, Kansas

STATE OF Texas, COUNTY OF Hutchinson, ss.

(employee of owner) or (owner or operator) of the above-described well, being first duly sworn on oath, says: That I have knowledge of the facts, statements, and matters herein contained and the log of the above-described well as filed and that the same are true and correct. So help me God.

(Signature) [Signature]

Box 358, Borger, Texas 79007
(Address)

SUBSCRIBED AND SWORN TO before me this 19th day of December, 19 67

My commission expires 6-1-69 Notary Public.

* Notified Mr. Edgar J. Eves office on 12-8-67.