

WELL PLUGGING RECORD

Give All Information Completely  
Make Required Affidavit  
Mail or Deliver Report to:  
Conservation Division  
State Corporation Commission  
211 No. Broadway  
Wichita, Kansas

Kearny County. Sec. 27 Twp. 21S Rge. 35 ~~XXX~~ (W)

Location as "NE/CNW/SW" or footage from lines C SW/4 NW/4

Lease Owner Pan American Petroleum Corporation

Lease Name G. R. Endicott Well No. 1

Office Address Box 432, Liberal, Kansas

Character of Well (completed as Oil, Gas or Dry Hole) Dry Hole

Date well completed 12-10 19 65

Application for plugging filed 12-28 19 65

Application for plugging approved Hugh Scott 12-28 19 65


Plugging commenced 12-28 19 65

Plugging completed 12-30 19 65

Reason for abandonment of well or producing formation Dry Hole

If a producing well is abandoned, date of last production 19

Was permission obtained from the Conservation Division or its agents before plugging was commenced? Yes

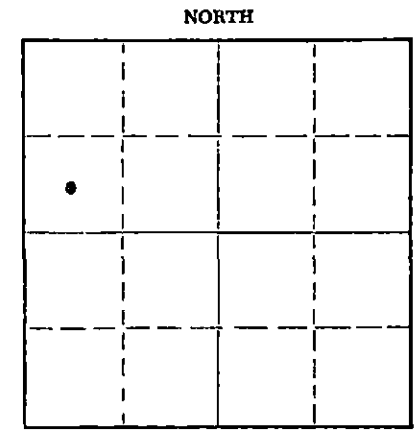

Locate well correctly on above Section Plat

Name of Conservation Agent who supervised plugging of this well Hugh Scott

Producing formation None Depth to top \_\_\_\_\_ Bottom \_\_\_\_\_ Total Depth of Well 4650 Feet

Show depth and thickness of all water, oil and gas formations.

OIL, GAS OR WATER RECORDS

CASING RECORD

FORMATION	CONTENT	FROM	TO	SIZE	PUT IN	PULLED OUT
Des Moines	Water	4426	4616	8-5/8	1240	None
				5-1/2	4672	1646

Describe in detail the manner in which the well was plugged, indicating where the mud fluid was placed and the method or methods used in introducing it into the hole. If cement or other plugs were used, state the character of same and depth placed, from \_\_\_\_\_ feet to \_\_\_\_\_ feet for each plug set.

Hvy Mud	4650-1600
20 Sx. Cement	1600-1500
Hvy Mud	1500-700
35 sx. cement	700-600
Hvy Mud	600-45
15 sx. cement	40-0

RECEIVED  
STATE CORPORATION COMMISSION  
JAN 10 1966  
WICHITA, KANSAS

(If additional description is necessary, use BACK of this sheet)  
Name of Plugging Contractor Sargents Casing Pulling Service  
Address Liberal, Kansas

STATE OF Kansas, COUNTY OF Seward, ss.  
I, D. M. Liles (employee of owner) or owner of the above-described well, being first duly sworn on oath, says: That I have knowledge of the facts, statements, and matters herein contained and the log of the above-described well as filed and that the same are true and correct. So help me God.  
(Signature) [Signature]  
Box 432, Liberal, Kansas  
(Address)

SUBSCRIBED AND SWORN to before me this 7 day of January, 1966  
My commission expires February 11, 1968  
[Signature] Notary Public.

PAN AMERICAN PETROLEUM CORPORATION

WELL RECORD

SUPPLEMENTAL (ENTER "X" WHEN APPLICABLE)

Grid for well location with '21' in the center.

LEASE G. R. Endicott WELL NO. 1
LOCATION OF WELL: 1980 FT. NORTH SOUTH OF THE NORTH SOUTH LINE AND 660 FT.
EAST WEST OF THE WEST LINE OF THE 1/4 1/4 NW 1/4
OF SECTION 21 TOWNSHIP 21 SOUTH RANGE 35 EAST WEST
Kearny Kansas
COUNTY STATE
ELEVATION: Ground 3107 RDB 3116
COMPLETED AS: OIL WELL GAS WELL WATER WELL DRY HOLE
DRILLING COMMENCED 11-6-1965 COMPLETED 12-10-1965

LOCATE WELL CORRECTLY

OPERATING COMPANY Pan American Petroleum Corporation ADDRESS Box 432, Liberal, Kansas

OIL OR GAS SANDS OR ZONES

Table with columns: NAME, FROM, TO, NAME, FROM, TO. Row 1: Des Moines, 4426, 4616, 4.

WATER SANDS

Table with columns: NAME, FROM, TO, WATER LEVEL, NAME, FROM, TO, WATER LEVEL. Row 1: Not Known, 3.

CASING RECORD (OVERALL MEASUREMENT)

LINER-SCREEN RECORD

Tables for casing and liner-screen records with columns for size, weight, threads, make, grade, quantity, size, quantity, set at, make and type.

PACKER RECORD

Table for packer record with columns: size, length, set at, make and type.

CEMENTING RECORD

MUDDING RECORD

Tables for cementing and mudding records with columns for size, where set, cement, method, final press, method, results.

WHAT METHOD WAS USED TO PROTECT SANDS WHEN OUTER STRINGS WERE PULLED? WERE BOTTOM HOLE PLUGS USED?

IF SO, STATE KIND, DEPTH SET, AND RESULTS OBTAINED

ROTARY TOOLS WERE USED FROM 0 FEET TO 4650 FEET, AND FROM FEET TO FEET

To Test

CABLE TOOLS WERE USED FROM FEET TO FEET, AND FROM FEET TO FEET

24-HOUR PRODUCTION OR POTENTIAL TEST Dry Hole


WATER BBLs.

IF GAS WELL, CUBIC FEET PER 24 HOURS SHUT-IN PRESSURE LBS. PER SQUARE IN.

I, THE UNDERSIGNED, BEING FIRST DULY SWORN UPON OATH, STATE THAT THIS WELL RECORD IS TRUE AND CORRECT ACCORDING TO THE RECORDS OF THIS OFFICE AND TO THE BEST OF MY KNOWLEDGE AND BELIEF.

SUBSCRIBED AND SWORN TO BEFORE ME THIS 7 DAY OF January 19 66 MY COMMISSION EXPIRES February 11, 1968

Area Supt. Notary Public signature and stamp

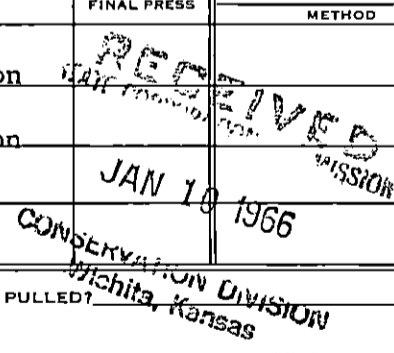

FORMATION RECORD

DESCRIBE EACH FORMATION DRILLED. INDICATE THICKNESS, CONTENT AND WHETHER DRY, OR OIL, GAS, OR WATER BEARING.

FORMATION	TOP	BOTTOM	FORMATION	TOP	BOTTOM
Clay	0	60			
Sand	60	130			
Shale	130	975			
Red Beds	975	1250			
Sahel, Red Bed	1250	1680			
Sand	1680	1780			
Red Bed, Gyp	1780	1970			
Anhydrite	1970	2142			
Shale, Shells	2142	2620			
Lime, Shale	2620	3215			
Lime	3215	3330			
Lime, Shale	3330	3455			
Lime, Chalk	3455	3775			
Lime, Shale	3775	3910			
Lime	3910	4570			
Lime, Shale	4570	4610			
Lime	4610	4650			
Total Depth		4650			