


STATE OF KANSAS
STATE CORPORATION COMMISSION

WELL PLUGGING RECORD

Give All Information Completely
Make Required Affidavit
Mail or Deliver Report to
Conservation Division
State Corporation Comm.
245 North Water
Wichita, KS 67202

Kerny County. Sec. 23 Twp. 21S Rge. 35 E/W W
Location as "NE/CNW $\frac{1}{4}$ SW $\frac{1}{4}$ " or footage from lines
1300' FNL 1250' FWL

Lease Owner Wallace Oil & Gas, Inc.
Lease Name Campbell Well No. 1
Office Address 50 Penn Place, Suite Okla. City, Okla. 73118
Character of Well (Completed as Oil, Gas or Dry Hole) _____

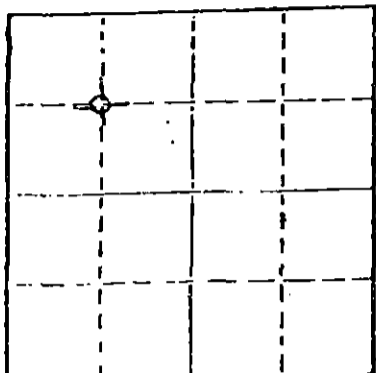

Locate well correctly on above
Section Plot

Character of Well (Completed as Oil, Gas or Dry Hole) Gas
Date Well completed _____ 19____
Application for plugging filed 12-10 1979
Application for plugging approved 12-12 1979
Plugging commenced 12-20 1979
Plugging completed 12-22 1979
Reason for abandonment of well or producing formation _____

If a producing well is abandoned, date of last production _____ 19____

Was permission obtained from the Conservation Division or its agents before plugging was commenced? Yes

Name of Conservation Agent who supervised plugging of this well Clarence Thomas
Producing formation _____ Depth to top _____ Bottom _____ Total Depth of Well 2691 on _____
Show depth and thickness of all water, oil and gas formations. _____ 2750

OIL, GAS OR WATER RECORDS

CASING RECORD

FORMATION	CONTENT	FROM	TO	SIZE	PUT IN	PULLED OUT
				8 5/8	372	none
				4 1/2	2739	1624

Describe in detail the manner in which the well was plugged, indicating where the mud fluid was placed and the method or methods used in introducing it into the hold. If cement or other plugs were used, state the character of same and depth placed, from _____ feet to _____ feet for each plug set.

Pump 15 sks. of cement @ 2688 to 2550
Pump 35 sks. of cement @ 380 to 280
Put 10 sks. of cement @ 40 to 0

RECEIVED 1-8-1980
STATE CORPORATION COMMISSION
JAN 8 1980
CONSERVATION DIVISION
Wichita, Kansas

(If additional description is necessary, use BACK of this _____)

Name of Plugging Contractor Sargents Casing Pulling Service Box 506 Liberal, Kansas 67901

STATE OF Oklahoma COUNTY OF Oklahoma, ss.
Phil Wallace (employee of owner) or (owner or operator)
of the above-described well, being first duly sworn on oath, says: That I have knowledge of the facts, statements, and matters herein contained and the log of the above-described well as filed and that the same are true and correct. So help me God.

(Signature) Phil Wallace
50 Penn Place, Suite 600, Okla. City, Okla.
(Address) 73118

SUBSCRIBED AND SWORN TO before me this 7th day of January, 1980

Betty Jean Weese
Notary Public.

My commission expires 12-2-82