

STATE OF KANSAS
STATE CORPORATION COMMISSION
200 Colorado Derby Bldg.
Wichita, Kansas 67202

RECEIVED
STATE CORPORATION COMMISSION Form CP-4
Rev. 12-15-80


OCT 01 1982

CONSERVATION DIVISION
Wichita, Kansas

WELL PLUGGING RECORD

Give All Information Completely
Make Required Affidavit

COUNTY Stafford SEC. 36 TWP. 21S RGE. 13W 36
Location as in quarters or footage from lines:
SW NE NE

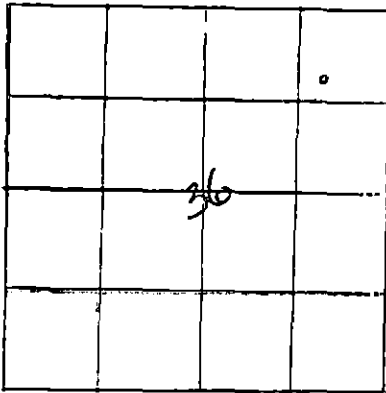

Locate Well
correctly on above
Section Platt.

Lease Owner Nadel and Gussman
Lease Name FISCHER Well No. C-6
Office Address 3232 First National Tower-Tulsa, OK 74103
Character of Well (Completed as Oil, Gas or Dry Hole): oil
Date Well Completed March 13, 1956
Application for plugging filed 8/13/82
Plugging commenced 9/8/82
Plugging completed 9/8/82
Reason for abandonment of well or producing formation Depleted

Was permission obtained from the Conservation Division or it's
Agent's before plugging was commenced? yes

Name of Conservation Agent who supervised plugging of this well J. H. Metz
Producing formation Arbuckle Depth to top 3651 bottom 3657 T.D. 3705
Show depth and thickness of all water, oil and gas formations.

OIL, GAS OR WATER RECORDS

Casing Record

Formation	Content	From	To	Size	Put in	Pulled Out
<u>Arbuckle</u>	<u>oil(depleted)</u>	<u>3651</u>	<u>3657</u>			
				<u>8-5/8"</u>	<u>322'</u>	<u>none</u>
				<u>5-1/2"</u>	<u>3702'</u>	<u>none</u>

Describe in detail the manner in which the well was plugged, indicating where the mud
fluid was placed and the method or methods used in introducing it into the hold. If cement
or other plugs were used, state the character of same and depth placed, from feet
to feet for each plug set.

200 sacks of 50/50 Poz and 3% Calcium Chloride were pumped down the 8-5/8" and 5-1/2"
annulus at the same time. Shutin pressure 500#.

(If additional description is necessary, use BACK of this sheet)

Name of Plugging Contractor Allied Cementing Company (Russell, Ks.)

STATE OF Oklahoma COUNTY OF Tulsa, ss.

M. R. Taylor, Mgr. of Production (employee of owner) or (owner or operator) of the
above-described well, being first duly sworn on oath, says: That I have knowledge of the
facts, statements, and matters herein contained and the log of the above-described well as
filed and that the same are true and correct. So help me God.

(Signature) *M. R. Taylor*
3232 First National Tower-Tulsa, OK 74103
(Address)

SUBSCRIBED AND SWORN TO before me this 28th day of September, 1982

Mildred Carter
Mildred Carter Notary Public.

My Commission expires: 5/11/83

WELL LOG

15.185.00337.0000

NADEL AND GUSSMAN

FISCHER C-6

SW NE NE 36-21S-13W

Stafford County, Kansas

Comm: 3- 2-56

Comp: 3-13-56

Casing: 8-5/8" 322' w/325 sax
5-1/2" 3702' w/425 sax

Formations

Depth

Geological Tops

Surface	320		
Red bed and shale	690		
Anhydrite	720	Brown Lime	3284
Shale and shells	1550	Lansing-Kansas City	3301
Shale and lime	1990	Base Kansas City	3523
Lime	2155	Viola	3556
Shale and lime	2475	Simpson Shale	3587
Shale	2735	Simpson Sand	3626
Shale and lime	2995	Arbuckle	3640
Lime	3640		
Arbuckle	3705		

RECEIVED
STATE CORPORATION COMMISSION
AUG 16 1982
CONSERVATION DIVISION
Wichita, Kansas

STATE OF KANSAS)
) SS:
COUNTY OF SEDGWICK)

L. C. Hay, of lawful age, states that the above tops, formations and depths are correct as shown by the daily drilling log on the Fischer C 6 in the SW NE NE 36-21S-13W, Stafford County, Kansas.

L. C. Hay
L. C. Hay

Subscribed and sworn to before me this 15th day of March, 1956.

Nola Babb
Nola Babb, Notary Public

My commission expires Nov. 3, 1956