


WELL PLUGGING RECORD

Give All Information Completely  
Make Required Affidavit  
May or Deliver Report to:  
Conservation Division  
State Corporation Commission  
800 Biting Building  
Wichita, Kansas

Stafford County, Sec. 36 Twp. 21 Rge. 13 (W)

Location as "NE/CNW/SW" or footage from lines NE SW SW  
Lease Owner Anschutz Drilling Company  
Lease Name Fischer Estate Well No. 2  
Office Address Union Nat'l Bk Bldg., Wichita, Kansas  
Character of Well (completed as Oil, Gas or Dry Hole) Dry Hole  
Date well completed 4-20 1953  
Application for plugging filed 6-1 1953  
Application for plugging approved 6-1 1953  
Plugging commenced 6-2 1953  
Plugging completed 6-13 1953  
Reason for abandonment of well or producing formation Oil string set, well tested, dry hole

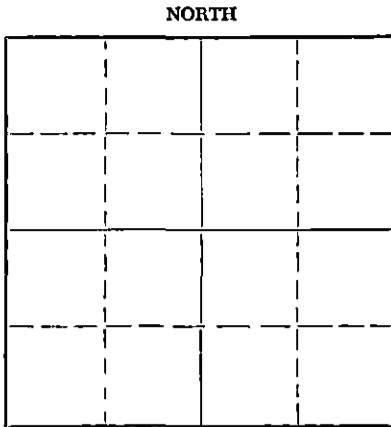

Locate well correctly on above Section Plat

If a producing well is abandoned, date of last production 19  
Was permission obtained from the Conservation Division or its agents before plugging was commenced? Yes

Name of Conservation Agent who supervised plugging of this well M. A. Rives  
Producing formation \_\_\_\_\_ Depth to top \_\_\_\_\_ Bottom \_\_\_\_\_ Total Depth of Well 3710 Feet  
Show depth and thickness of all water, oil and gas formations.

OIL, GAS OR WATER RECORDS

CASING RECORD

FORMATION	CONTENT	FROM	TO	SIZE	PUT IN	PULLED OUT
				8-5/8"	253'	
				5-1/2"	3709'	1418'

Describe in detail the manner in which the well was plugged, indicating where the mud fluid was placed and the method or methods used in introducing it into the hole. If cement or other plugs were used, state the character of same and depth placed, from \_\_\_\_\_ feet to \_\_\_\_\_ feet for each plug set.

Plugged back to 3665' with crushed rock-  
dumped 5 sacks cement - mudded back to  
240' - 5' rock bridge on top - 20 sacks cement-  
mud back to 35' - 5' rock - 10 sacks cement

RECEIVED  
STATE CORPORATION COMMISSION  
JUN 20 1956  
CONSERVATION DIVISION  
Wichita, Kansas

(If additional description is necessary, use BACK of this sheet)  
Name of Plugging Contractor Ace Pipe Pulling Co.  
Address Great Bend, Kansas

STATE OF KANSAS, COUNTY OF SEDGWICK, ss.  
Leon L. Mehler (employee of owner) or (owner or operator) of the above-described well, being first duly sworn on oath, says: That I have knowledge of the facts, statements, and matters herein contained and the log of the above-described well as filed and that the same are true and correct. So help me God.

(Signature) Leon L. Mehler  
Union Nat'l Bk Bldg., Wichita, Kansas  
(Address)

SUBSCRIBED AND SWORN TO before me this 19th day of June, 19 53

My commission expires May 2, 1956

Jacqueline Hanna  
Notary Public.

**PLUGGING**  
FILE SEC 36 T 21 R 13W  
BOOK PAGE 107 LINE 41

