


WELL PLUGGING RECORD

Give All Information Completely
Make Required Affidavit
Mail or Deliver Report to:
Conservation Division
State Corporation Commission
800 Bldg Building
Wichita, Kansas

Stafford County. Sec. 36 Twp. 21 Rge. (E) 13 (W)
Location as "NE/CNW/SW" or footage from lines SW SW NW
Lease Owner Fred B. Anschutz
Lease Name Fischer Estate Well No. 4
Office Address 1019 Central Bldg., Wichita 2, Kansas
Character of Well (completed as Oil, Gas or Dry Hole) Oil
Date well completed 4-15- 1954
Application for plugging filed 5-17- 1956
Application for plugging approved 5-17- 1956
Plugging commenced 5-25- 1956
Plugging completed 5-30- 1956
Reason for abandonment of well or producing formation Depleted

NORTH

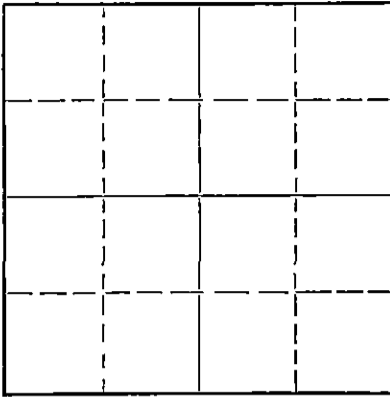

Locate well correctly on above
Section Plat

If a producing well is abandoned, date of last production 5-10- 1956
Was permission obtained from the Conservation Division or its agents before plugging was commenced? Yes

Name of Conservation Agent who supervised plugging of this well R. M. Brundage
Producing formation Arbuckle Depth to top _____ Bottom _____ Total Depth of Well _____ Feet
Show depth and thickness of all water, oil and gas formations.

OIL, GAS OR WATER RECORDS

CASING RECORD

FORMATION	CONTENT	FROM	TO	SIZE	PUT IN	PULLED OUT
Arbuckle	oil & water	3662	3679	5-1/2"	3667	3016
				8-5/8"	245'	None

Describe in detail the manner in which the well was plugged, indicating where the mud fluid was placed and the method or methods used in introducing it into the hole. If cement or other plugs were used, state the character of same and depth placed, from _____ feet to _____ feet for each plug set.

3706 to 3655 ft. Sand bridge
 3655 to 3630 ft. 5 sacks cement
 3630 to 240 ft. Mudded
 240 to 230 ft. Rock bridge
 230 to 170 ft. 20 sacks cement
 170 to 35 ft. Mud
 35 ft. to cellar 10 sacks cement

(If additional description is necessary, use BACK of this sheet)

Name of Plugging Contractor R & S Pipe Pulling Co.
Address Box 192, Ellinwood, Kansas

STATE OF KANSAS, COUNTY OF SEDGWICK, ss. John W. Ritchey Agent
(employee of owner) or (owner or operator) of the above-described well, being first duly sworn on oath, says: That I have knowledge of the facts, statements, and matters herein contained and the log of the above-described well as filed and that the same are true and correct. So help me God.

(Signature) John W. Ritchey
1019 Central Bldg., Wichita 2, Kansas
(Address)

SUBSCRIBED AND SWORN to before me this 11th day of June, 1956.

My commission expires May 31, 1960.

24-7368-S 3-53-20M

RECEIVED
STATE CORPORATION COMMISSION

Notary Public.

PLUGGING
FILE SEC. 36 T. 21 R. 13W
BOOK PAGE 62 LINE 15

JUN 14 1956
CONSERVATION DIVISION
WICHITA, KANSAS

6-14-56

DRILLER'S LOG

Fred B. Anschutz
 Fischer Estate #4
 SW SW NW 36-21-13W
 Stafford County, Kansas

<u>TO</u>	<u>FROM</u>	
0	230	Sand
230	250	Red Bed
250	702	Shale & Red Bed
702	730	Anhydrite
730	815	Shale & Shell
815	1215	Shale & Salt
1215	1555	Shale & Shells
1555	2245	Lime
2245	2450	Lime & Shale
2450	2595	Shale
2595	2815	Shale & Lime
2815	2910	Lime
2910	3110	Lime & Shale
3110	3170	Lime
3170	3327	Lime & Shale
3327	3538	Lime
3538	3598	Lime & Shale
3598	3667	Lime
	3667	ROTARY TOTAL DEPTH

COMMENCED: 3-26-54
 COMPLETED: 4-5-54

CASING RECORD:

Set 8-5/8" at 245' with 200 sacks of cement.
 Set 5 1/2" at 3667' with 100 sacks of cement.

STATE OF KANSAS)
) SS
 COUNTY OF SEDGWICK)

I hereby affirm that the above and foregoing is a true and correct copy of the log of the Fischer Estate #4 located SW SW NW, 36-21-13W, Stafford County, Kansas.

ANSCHUTZ DRILLING CO., INC.

BY: E. G. Koelling
 E. G. Koelling

Subscribed and sworn to before me this 7th day of April, 1954.

Helmer L. Lang
 Notary Public

My Commission Expires: November 21, 1956.

PLUGGING
 FILE SEC. 36 T. 31 R. 13W
 BOOK PAGE 62 LINE 15