


STATE OF KANSAS
STATE CORPORATION COMMISSION

WELL PLUGGING RECORD

Give All Information Completely
Make Required Affidavit
Mail or Deliver Report to
Conservation Division
State Corporation Comm.
245 North Water
Wichita, KS 67202

Stafford County, Sec. 36 Twp. 21S Rge. 13 E/W
Location as "NE/CNW $\frac{1}{4}$ SW $\frac{1}{4}$ " or footage from lines
N E - N W - N W

Lease Owner: Nadel & Gussman
Lease Name Fischer Well No. 2
Office Address Box 14 Great Bend, Kansas 67530
Character of Well (Completed as Oil, Gas or Dry Hole)
S W D

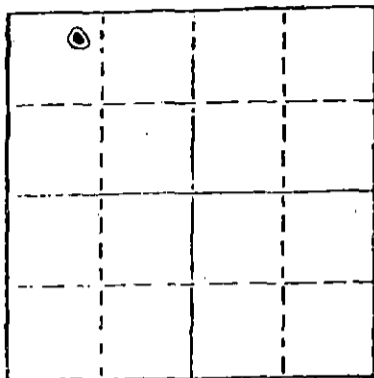

Locate well correctly on above
Section Plat

Date Well completed March 1979
Application for plugging filed July 22 1977
Application for plugging approved July 27 1977
Plugging commenced 8/2/77 19
Plugging completed 8/2/77 19
Reason for abandonment of well or producing formation
Not needed at this time for SWD
If a producing well is abandoned, date of last production 19

Was permission obtained from the Conservation Division or
its agents before plugging was commenced? Yes

Name of Conservation Agent who supervised plugging of this well Jasper H. Metz
Producing formation _____ Depth to top _____ Bottom _____ Total Depth of Well 4160'
Show depth and thickness of all water, oil and gas formations.

OIL, GAS OR WATER RECORDS

CASING RECORD

FORMATION	CONTENT	FROM	TO	SIZE	PUT IN	PULLED OUT
Arbuckle & Wash		No pipe recovered.				

Describe in detail the manner in which the well was plugged, indicating where the mud fluid
was placed and the method or methods used in introducing it into the hold. If cement or other
plugs were used, state the character of same and depth placed, from _____ feet to
_____ feet for each plug set.

Plug back to 3500' squeezed w/20 sx of gell & 150 sx of 50/50 posmix 6% gell.
Squeezed at 500# PSI.

RECEIVED
STATE CORPORATION COMMISSION

AUG 12 1977

CONSERVATION DIVISION
Wichita, Kansas

(If additional description is necessary, use BACK of this sheet)

Name of Plugging Contractor Owner & allied cementing CO.

STATE OF Kansas COUNTY OF Stafford, ss.
Frank Neff (employee of owner) or ~~owner~~

of the above-described well, being first duly sworn on oath, says: That I have knowledge of
the facts, statements, and matters herein contained and the log of the above-described well
as filed and that the same are true and correct. So help me God.

(Signature)

Frank Neff

(Address)

SUBSCRIBED AND SWORN TO before me this 11th day of August, 1977

Vada G. Gilliland

Notary Public.

My commission expires March 13, 1979



15.185.11650.0001

WELL LOG

MADEL AND GUSSMAN
TULSA, OKLAHOMA

Fischer No. 2

NE NW 1/4 36-21S-13W
Stafford County
Kansas

Casing:
297' of 8 1/2" 200 sax cem.
3806' of 5 1/2" 200 sax cem.
4160' T.D.

<u>Formations</u>	<u>Depth</u>
Sand and gravel	230
Red Bed	305
Red Bed and shale	700
Anhydrite	740
Shale and shells	1565
Shale and lime	1655
Broken lime	1715
Lime	1955
Lime and shale	2220
Shale and shells	2335
Shale and lime	2455
Shale and shells	3655
Shale and lime	2755
Shale and shells	2850
Shale and lime	2940
Lime	3596
Conglomerate	3664
Chert and conglomerate	3696
Chert and shale	3716
Shale	3731
Arbuckle lime	3806

RECEIVED
STATE COLLEGE OF GEOL. & MINING

JUL 27 1977

CONSERVATION DIVISION
Wichita, Kansas

STATE OF KANSAS)
) SS:
COUNTY OF SEDGWICK)

L. C. Hay, of lawful age, being first duly sworn on oath, deposes and states that the above is a true record of formations and depths as shown by the daily drilling report on above well.

L. C. Hay

Subscribed and sworn to before me this 31st day of March, 1949.

W. L. Cook
Notary Public

My commission expires Nov. 3, 1952