


STATE OF KANSAS
STATE CORPORATION COMMISSION

Form CP-4

Give All Information Completely
Make Required Affidavit
Mail or Deliver Report to:
Conservation Division
State Corporation Commission
212 No. Market
Wichita, Kansas

WELL PLUGGING RECORD

NORTH

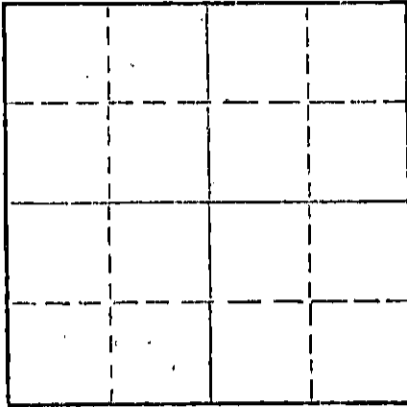

Locate well correctly on above
Section Plat

Rice County. Sec. 36 Twp. 21S Rge. 10W (E) (W)
Location as "NE/CNWxSWx" or footage from lines NW NW SE
Lease Owner John O. Farmer
Lease Name Swartz Well No. 1
Office Address 379 W. Wichita - Russell, Kansas
Character of Well (completed as Oil, Gas or Dry Hole) D & A
Date well completed May 13, 1967
Application for plugging filed May 13, 1967
Application for plugging approved May 13, 1967
Plugging commenced May 13, 1967
Plugging completed May 13, 1967
Reason for abandonment of well or producing formation D & A

If a producing well is abandoned, date of last production 19
Was permission obtained from the Conservation Division or its agents before plugging was commenced? Yes

Name of Conservation Agent who supervised plugging of this well Gilbert Toman
Producing formation _____ Depth to top _____ Bottom _____ Total Depth of Well 3617 Feet
Show depth and thickness of all water, oil and gas formations.

OIL, GAS OR WATER RECORDS

CASING RECORD

FORMATION	CONTENT	FROM	TO	SIZE	PUT IN	PULLED OUT
				8 5/8"	208'	-0-

Describe in detail the manner in which the well was plugged, indicating where the mud fluid was placed and the method or methods used in introducing it into the hole. If cement or other plugs were used, state the character of same and depth placed, from _____ feet to _____ feet for each plug set.

Filled hole w/mud to 200'.
Set plug w/1/2 sx hulls & 25
sx cement. Mud to 40'.
Set plug w/hulls & cement
to base of cellar. 2 sx
cement in rathole.

RECEIVED
STATE CORPORATION COMMISSION

MAY 18 1967

CONSERVATION DIVISION
Wichita, Kansas

(If additional description is necessary, use BACK of this sheet)

Name of Plugging Contractor Red Tiger Drilling Company
Address 1720 Wichita Plaza - Wichita, Kansas

STATE OF KANSAS, COUNTY OF SEDGWICK, ss.
Maxine V. Starr (employee of owner) or (owner or operator) of the above-described

well, being first duly sworn on oath, says: That I have knowledge of the facts, statements, and matters herein contained and the log of the above described well as filed and that the same are true and correct. So help me God.

(Signature) Maxine V. Starr

1720 Wichita Plaza - Wichita, Kansas
(Address)

Subscribed and Sworn to before me this 16th day of May, 1967

Betty M. Maloney Notary Public.

My commission expires 3-22-71

DRILLERS LOG

Swartz No. 1

CASING RECORD: 8 5/8" @ 208' w/190 sx cement
 COMPANY: John O. Farmer
 CONTRACTOR: Red Tiger Drilling Company
 COMMENCED: May 5, 1967
 COMPLETED: May 13, 1967
 DESCRIPTION: NW NW SE
 36-21S-10W
 Rice Co., Ks.
 ELEVATION:
 TOTAL DEPTH: 3617'

<u>FORMATION</u>	<u>FROM</u>	<u>TO</u>	<u>REMARKS</u>
Sand	0	92	
Red Bed	92	358	
Anhydrite	358	370	
Shale	370	525	
Shale & Shells	525	1226	
Lime & Shale	1226	2795	
Lime	2795	2919	
Heebner	2919	2924	
Lime & Shale	2924	3092	
Lime	3092	3415	
Lime & Shale	3415	3432	
Conglomerate	3432	3450	
Viola	3450	3470	
Chertz-Lime	3470	3567	
Arbuckle	3567	3617	

RECEIVED
 MAY 18 1967
 COMMISSION DIVISION
 State of Kansas

I certify that this is a true and correct copy of the above log to the best of my knowledge.

RED TIGER DRILLING COMPANY

Maxine V. Starr
 Maxine V. Starr

Subscribed and sworn to before me this 16th day of May, 1967.

Betty M. Maloney
 Notary Public

My Commission Expires:

3-22-71