


STATE OF KANSAS
STATE CORPORATION COMMISSION

WELL PLUGGING RECORD

Give All Information Completely
Make Required Affidavit
Mail or Deliver Report to:
Conservation Division
State Corporation Commission
800 Bittling Building
Wichita, Kansas

Rice County County. Sec. 28 Twp. 21S Rge. 10 (W)
Location as "NE/CNW 1/4 SW 1/4" or footage from lines NE NE SW
Lease Owner Black Cat Oil Company
Lease Name Price Well No. # 1
Office Address Box 62, Great Bend, Kansas
Character of Well (completed as Oil, Gas or Dry Hole) Dry
Date well completed May 16, 19 51
Application for plugging filed May 18, 19 51
Application for plugging approved May 18, 19 51
Plugging commenced May 16, 19 51
Plugging completed May 16, 19 51
Reason for abandonment of well or producing formation Dry

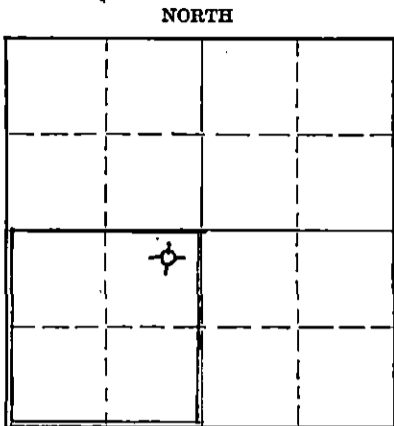

Locate well correctly on above
Section Plat

If a producing well is abandoned, date of last production 19
Was permission obtained from the Conservation Division or its agents before plugging was commenced? Yes

Name of Conservation Agent who supervised plugging of this well Mr. Ruel Durkee, Box 597, McPherson, Kansas
Producing formation - - - Depth to top - - - Bottom - - - Total Depth of Well 3525' Feet
Show depth and thickness of all water, oil and gas formations.

OIL, GAS OR WATER RECORDS

CASING RECORD

Formation	Content	From	To	Size	Put In	Pulled Out
				8-5/8"	130'	x x x

Describe in detail the manner in which the well was plugged, indicating where the mud fluid was placed and the method or methods used in introducing it into the hole. If cement or other plugs were used, state the character of same and depth placed, from 3525' feet to 0 feet for each plug set.

Filled hole with heavy mud; pushed bottom plug to 130';
cemented with 15 sacks; pushed top plug to 30'; cemented with
5 sacks.

(If additional description is necessary, use BACK of this sheet)

Correspondence regarding this well should be addressed to Black Cat Oil Company
Address Box 62, Great Bend, Kansas

STATE OF Kansas COUNTY OF Barton, ss.
Leon F. Huff, Partner of

(Employee of owner) or (owner or operator) of the above-described well,
being first duly sworn on oath, says: That I have knowledge of the facts, statements, and matters herein contained and the log of the above-described well as filed and that the same are true and correct. So help me God.

(Signature) Leon F. Huff
Box 62, Great Bend, Kansas
(Address)

SUBSCRIBED AND SWORN TO before me this 23rd day of May, 19 51.

My commission expires April 4, 1955

23-8273-8 4-50-10M

RECEIVED
STATE CORPORATION COMMISSION
Notary Public.

JUN - 5 1951

CONSERVATION DIVISION
Wichita, Kansas

PLUGGING
FILE SEC 28 T 21 R 10W
BOOK PAGE 22 LINE 42

DRILLER'S LOG

OPERATOR: Black Cat Oil Company
 FARM NAME: Price
 WELL NUMBER: #1
 CONTRACTOR: Black Cat Oil Company
 ROTARY COMMENCED: May 4, 1951
 ROTARY COMPLETED: May 16, 1951
 ELEVATION: 1750'DF

Location: NE NE SW Sec. 28-21S-10W
 Rice County, Kansas

Casing Record:
 8-5/8" @ 140', cemented
 w/125 sacks cement and 1
 calcium chloride.

Initial Production: DRY

Figures denote bottom of formation

Sand and Shale	120
Red Bed	400
Anhydrite	425
Shale and Shells	990
Salt, Shale and Shells	1,070
Shale and Shells	1,275
Lime	1,470
Shale and Lime	1,845
Lime	2,000
Shale and Shell	2,220
Lime and Shale	2,850
Lime	2,910
Lime and Shale	3,090
Lime	3,400
Conglomerate Cherty	3,440
Lime	3,525

Rotary Total Depth

RECEIVED
 STATE CORPORATION COMMISSION
 MAY 22 1951
 CONSERVATION DIVISION
 Wichita, Kansas

CERTIFICATE

STATE OF KANSAS)
) SS
 BARTON COUNTY)

I hereby certify that the foregoing is, to the best of my knowledge and belief, a full, true and correct drilling log as shown by the daily drilling reports in connection with the aforesaid well.

Leola F. Huff
 Leola F. Huff, Partner of
 Black Cat Oil Company

Subscribed and sworn to before me, the undersigned, a Notary Public, this 16th day of May, 1951.

Peggy L. Shank
 Peggy L. Shank
 Notary Public

My commission expires April 4, 1955

PLUGGING
 FILE SEC 28-21-10W
 BOOK PAGE 82 LINE 42

DRILLER'S LOG

OPERATOR: Black Cat Oil Company
FARM NAME: Price
WELL NUMBER: #1

Location: NE NE SW Sec. 28-219-10W
Edice County, Kansas

CONTRACTOR: Black Cat Oil Company

Casing Record:
8-5/8" C 140', cemented
w/125 sacks cement and 1
calcium chloride.

ROTARY COMMENCED: May 4, 1951
ROTARY COMPLETED: May 16, 1951

Initial Production: DRY

ELEVATION: 1750'DF

Figures denote bottom of formation

Sand and Shale	120
Red Bed	400
Anhydrite	425
Shale and Shells	990
Salt, Shale and Shells	1,070
Shale and Shells	1,275
Lime	1,470
Shale and Lime	1,845
Lime	2,000
Shale and Shell	2,220
Lime and Shale	2,850
Lime	2,910
Lime and Shale	3,090
Lime	3,400
Conglomerate Cherty	3,440
Lime	3,525

Rotary Total Depth

C E R T I F I C A T E

STATE OF KANSAS)
BARTON COUNTY) SS

I hereby certify that the foregoing is, to the best of my knowledge and belief, a full, true and correct drilling log as shown by the daily drilling reports in connection with the aforesaid well.

Leon F. Huff
Leon F. Huff, Partner of
Black Cat Oil Company

Subscribed and sworn to before me, the undersigned, a Notary Public, this 18th day of May, 1951.

Reggie L. Shank
Reggie L. Shank
Notary Public

My commission expires April 4, 1955

RECEIVED
STATE CORPORATIONS COMMISSION
JUN - 5 1951
CONSERVATION DIVISION
Wichita, Kansas

PLUGGING
FILE SEC 28-21-10W
BOOK PAGE 82 LINE 42