


STATE OF KANSAS
STATE CORPORATION COMMISSION

WELL PLUGGING RECORD

Give All Information Completely
Make Required Affidavit
Mail or Deliver Report to:
Conservation Division
State Corporation Commission
800 Bitting Building
Wichita, Kansas

Ellis County. Sec. 17 Twp. 12 Rge. 17 (E) W (W)
Location as "NE/CNW%SW%" or footage from lines NE NE SE
Lease Owner B & R Drilling, Inc.
Lease Name Miller B Well No. 1
Office Address Russell, Kansas
Character of Well (completed as Oil, Gas or Dry Hole) Dry Hole
Date well completed 8/30/52 19
Application for plugging filed 8/28/52 19
Application for plugging approved 8/28/52 19
Plugging commenced 8/29/52 19
Plugging completed 8/29/52 19
Reason for abandonment of well or producing formation Dry Hole

NORTH

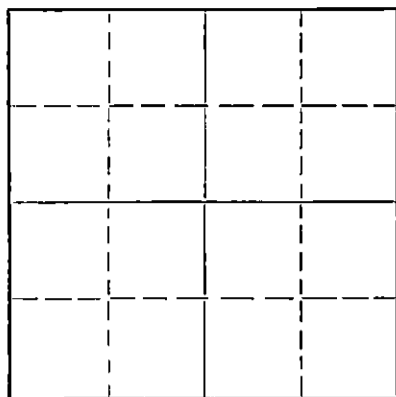

Locate well correctly on above
Section Flat

If a producing well is abandoned, date of last production _____ 19____
Was permission obtained from the Conservation Division or its agents before plugging was commenced? Yes

Name of Conservation Agent who supervised plugging of this well Eldon Petty
Producing formation _____ Depth to top _____ Bottom _____ Total Depth of Well 3825 Feet
Show depth and thickness of all water, oil and gas formations.

OIL, GAS OR WATER RECORDS

CASING RECORD

FORMATION	CONTENT	FROM	TO	SIZE	PUT IN	PULLED OUT
				8 5/8"	213	None

Describe in detail the manner in which the well was plugged, indicating where the mud fluid was placed and the method or methods used in introducing it into the hole. If cement or other plugs were used, state the character of same and depth placed, from _____ feet to _____ feet for each plug set.

PLUGGING RECORD

Filled hole with heavy mud to 205', set bottom plug, ran 15 sacks cement through drill pipe. Filled hole with heavy mud to 40', set top plug (tied to surface pipe), 1/2 sack hulls & 10 sacks cement.

(If additional description is necessary, use BACK of this sheet)

Name of Plugging Contractor _____
Address _____

STATE OF KANSAS, COUNTY OF RUSSELL, ss.
W. A. Michaelis, Jr. (employee of owner) or (owner or operator) of the above-described well, being first duly sworn on oath, says: That I have knowledge of the facts, statements, and matters herein contained and the log of the above-described well as filed and that the same are true and correct. So help me God.

(Signature) W. A. Michaelis, Jr.
Russell, Kansas
(Address)

SUBSCRIBED AND SWORN TO before me this 9th day of September, 1952

My commission expires 6-17-54.

[Signature]
Notary Public.
STATE CORPORATION COMMISSION

SEP 12 1952

PLUGGING
FILE SSS T R
BOOK PAGE LINE

9-12-52 CONSERVATION DIVISION
Wichita, Kansas

B & R Drilling, Inc.
Miller B-1

NE NE SE 17-12-17
Ellis County, Kansas

Total Depth: 3825'
Comm. 8/17/52
Comp. 8/30/52

Casing
8 5/8" Set @ 213'

Cement
140 sacks Victor

Formation	Depth
Lime-shells	70
Shale-shells	540
Shale-sand	750
Shale-shells	870
Sand	1040
Shale-shells	1160
Shale-shells-red bed	1390
Anhydrite	1425
Shale-shells	1800
Salt-shale	1970
Shale-lime	3403
Lime	3738
Conglomerate	3776
Lime	3825'

STATE OF KANSAS)
) ss
RUSSELL COUNTY)

I hereby certify that the above information is true and correct to the best of my knowledge.

-----*Lara Betz*-----

Subscribed and sworn to before me this 9th day of September, 1952.

-----*Clara Spence*-----
Notary Public

My commission expires: 6-17-54.

PLUGGING
FILE SEC T R
BOOK PAGE LINE

RECEIVED
STATE CORPORATION COMMISSION
SEP 12 1952
CONSERVATION DIVISION
Wichita, Kansas