


WELL PLUGGING RECORD

Give All Information Completely
Make Required Affidavit
Mail or Deliver Report to:
Conservation Division
State Corporation Commission
809 Bittling Building
Wichita, Kansas

Ellis County, Sec 12 Twp 12S Rge (E) 17 (W)

Location as "NE/CNW $\frac{1}{4}$ SW $\frac{1}{4}$ " or footage from lines SW NW NE
Lease Owner The Palmer Oil Corporation
Lease Name Hall "A" Well No. 1
Office Address 415 Union National Bank Bldg., Wichita, Kansas
Character of Well (completed as Oil, Gas or Dry Hole) Dry Hole
Date well completed May 13, 1952 19
Application for plugging filed May 21, 1952 19
Application for plugging approved 19
Plugging commenced May 9, 1952 19
Plugging completed May 10, 1952 19
Reason for abandonment of well or producing formation Dry Hole

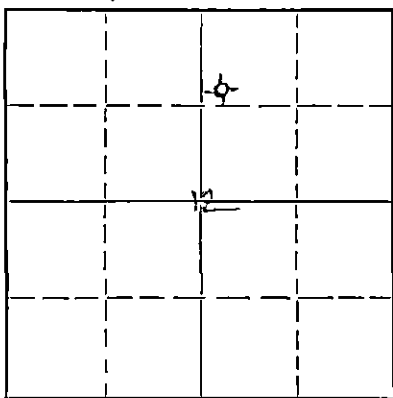

Locate well correctly on above Section Plat

If a producing well is abandoned, date of last production 19
Was permission obtained from the Conservation Division or its agents before plugging was commenced? Yes

Name of Conservation Agent who supervised plugging of this well
Producing formation Depth to top Bottom Total Depth of Well 3610 Feet
Show depth and thickness of all water, oil and gas formations.

OIL, GAS OR WATER RECORDS

CASING RECORD

Formation	Content	From	To	Size	Put In	Pulled Out

Describe in detail the manner in which the well was plugged, indicating where the mud fluid was placed and the method or methods used in introducing it into the hole. If cement or other plugs were used, state the character of same and depth placed, from feet to feet for each plug set.

Filled with heavy rotary mud every 500' while coming out of hole. Set plug at 300' cemented with 40 sacks. Set plug at 40 with 10 sacks cement.

RECEIVED
STATE CORPORATION COMMISSION
MAY 22 1952
CONSERVATION DIVISION
Wichita, Kansas

(If additional description is necessary, use BACK of this sheet)
Name of Plugging Contractor The Palmer Oil Corporation
Address 415 Union National Bank Building, Wichita 2, Kansas

STATE OF KANSAS, COUNTY OF SEDGWICK, ss.
Edgar E. Smith (employee of owner) or former proprietor of the above-described well, being first duly sworn on oath, says: That I have knowledge of the facts, statements, and matters herein contained and the log of the above-described well as filed and that the same are true and correct. So help me God.

(Signature) Edgar E. Smith
415 Union Nat'l. Bank Bldg., Wichita, Kansas
(Address)

SUBSCRIBED AND SWORN TO before me this 21st day of May, 1952

My commission expires 9/30/53 Notary Public.

PLUGGING
FILE SEC 12 T 12 R 17
BOOK PAGE 15 LINE 21

WELL LOG - HALL "A"

WELL OWNER: The Palmer Oil Corporation

Location: SW NW NE

Section 12-12S-17W

CONTRACTOR: The Palmer Oil Corporation

Ellis County, Kansas

Elevation: 1956 R. B.

Commenced: 4/28/52

Completed: 5/13/52

RESULTS: Dry Hole

Casing Record

8 5/8" - 328' cemented 175 sacks

Shale & shells	0	675
Sand	675	785
Red Bed	785	1132
Anhydrite	1132	1169
Shale	1169	1305
Shale & shells	1305	1520
Lime & shale	1520	3030
Lime	3030	3488
Conglomerate	3488	3604
Arbuckle	3604	3610 T. D.

Formation Tops (R. B.)

Anhydrite	1132
Heebner	3152
Lansing	3200
Cherty Conglomerate	3490
Arbuckle	3604

This is to certify that the above is a true and correct log, according to the daily drilling reports.

THE PALMER OIL CORPORATION

By

Edgar E. Smith

STATE OF KANSAS)
SEDGWICK COUNTY) SS:

Subscribed and sworn to before me, a Notary Public in said County and State this 21st day of May, 1952.

Olof M. Kelling
Notary Public

My Commission Expires: 9/30/53

PLUGGING
FILE SEC-12T/12R/12W
BOOK PAGE 15 LINE 5

RECEIVED
STATE CORPORATION COMMISSION
MAY 22 1952
CONSERVATION DIVISION
Wichita, Kansas