


WELL PLUGGING RECORD

Give All Information Completely
Make Required Affidavit
Mail or Deliver Report to:
Conservation Division
State Corporation Commission
211 No. Broadway
Wichita, Kansas

NORTH

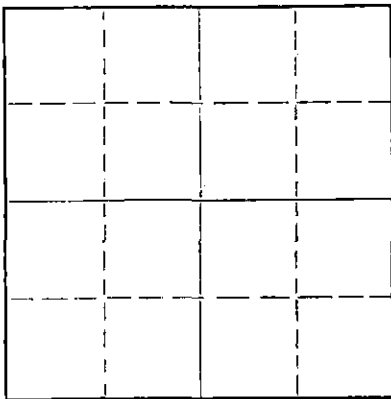

Locate well correctly on above
Section Plat

Ellis County. Sec. 32 Twp. 12 Rge. 16 (W)
Location as "NE/CNW/SW" or footage from lines C SE SE
Lease Owner Woodman & Iannitti Drilling Co.
Lease Name Windholz Well No. 1
Office Address 706 Union Nat'l. Bldg., Wichita 2
Character of Well (completed as Oil, Gas or Dry Hole) dry hole
Date well completed 1-22 19 63
Application for plugging filed 1-22 19 63
Application for plugging approved 1-22 19 63
Plugging commenced 1-22 19 63
Plugging completed 1-22 19 63
Reason for abandonment of well or producing formation dry hole

If a producing well is abandoned, date of last production 19
Was permission obtained from the Conservation Division or its agents before plugging was commenced? yes

Name of Conservation Agent who supervised plugging of this well Eldon Petty
Producing formation _____ Depth to top _____ Bottom _____ Total Depth of Well 3566 Feet
Show depth and thickness of all water, oil and gas formations.

OIL, GAS OR WATER RECORDS

CASING RECORD

FORMATION	CONTENT	FROM	TO	SIZE	PUT IN	PULLED OUT
				8 5/8	130'	

Describe in detail the manner in which the well was plugged, indicating where the mud fluid was placed and the method or methods used in introducing it into the hole. If cement or other plugs were used, state the character of same and depth placed, from _____ feet to _____ feet for each plug set.

Bottom Plug @ 500' w/20 sx cement
Middle Plug @ 180' w/20 sx cement
Top Plug @ 40' w/10 sx cement

RECEIVED
STATE CORPORATION COMMISSION

JAN 28 1963

CONSERVATION DIVISION
Wichita, Kansas

(If additional description is necessary, use BACK of this sheet)
Name of Plugging Contractor Woodman & Iannitti Drilling Co.
Address 706 Union Nat'l. Bldg., Wichita 2

STATE OF Kansas, COUNTY OF Sedgwick, ss.
K. T. Woodman (employee of owner) or (owner or operator) of the above-described well, being first duly sworn on oath, says: That I have knowledge of the facts, statements, and matters herein contained and the log of the above-described well as filed and that the same are true and correct. So help me God.

(Signature) K. T. Woodman

706 Union Nat'l. Bldg., Wichita
(Address)

SUBSCRIBED AND SWORN TO before me this 25th day of January, 1963

My commission expires Oct. 10, 1963

Frances H. Solomon
Notary Public.

FRANCES H. SOLOMON

INVOICED

DATE 1/28/63

INV. NO. 6484-W

KANSAS GEOLOGICAL SOCIETY
KANSAS WELL LOG BUREAU - KANSAS WELL SAMPLE BUREAU
KANSAS GEOLOGICAL SOCIETY BUILDING
508 EAST MURDOCK - WICHITA, KANSAS

15.051.01559.00.00

COMPANY Woodman & Iannitti Drilling Co.

SEC. 32 T. 12 R. 16W
LOC. C SE SE

FARM Windholz

NO. 1

TOTAL DEPTH 3566'

COMM. 1-14-63

COMP. 1-22-63


SHOT OR TREATED

CONTRACTOR Woodman & Iannitti Drilling Co.

ISSUED

COUNTY Ellis

KANSAS

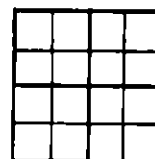

CASING

20	10
15	8 5/8" @ 130' W/100 sx cement
12	6
13	5

ELEVATION 2025 RB

PRODUCTION

FIGURES INDICATE BOTTOM OF FORMATIONS

0 -	40	Clay & Sand
	100	Clay
	135	Blue Shale
	435	Shale
	600	Clay
	730	Sand & Shale
	830	Sand
	1174	Red Bed
	1215	Anhydrite
	1830	Shale & Shells
	2065	Lime & Shale
	2575	Lime
	2725	Lime & Shale
	3540	Lime
	3566	Arbuckle

I certify the above to be a true and correct copy of the Driller's Log to the best of my knowledge and belief.

WOODMAN & IANNITTI DRILLING CO.

By:

K. T. Woodman

K. T. Woodman

RECEIVED
STATE CORPORATION COMMISSION

JAN 28 1963

CONSERVATION DIVISION
Wichita, Kansas