

STATE OF KANSAS  
STATE CORPORATION COMMISSION

WELL PLUGGING RECORD

Give All Information Completely  
Make Required Affidavit  
Mail or Deliver Report to:  
Conservation Division  
State Corporation Commission  
211 No. Broadway  
Wichita, Kansas

Ellis County. Sec. 22 Twp. 12W Rge. 16W (E) (W)

Location as "NE/CNW/SW" or footage from lines SW SW SW

Lease Owner Chester Loving & Murfin Drilling Co.

Lease Name Froelich Well No. 1

Office Address Russell, Kansas

Character of Well (completed as Oil, Gas or Dry Hole) dry hole

Date well completed 1-15 19 57

Application for plugging filed 1-15 19 57

Application for plugging approved 1-15 19 57


Plugging commenced 1-15 19 57

Plugging completed 1-15 19 57

Reason for abandonment of well or producing formation dry

If a producing well is abandoned, date of last production 19

Was permission obtained from the Conservation Division or its agents before plugging was commenced? yes

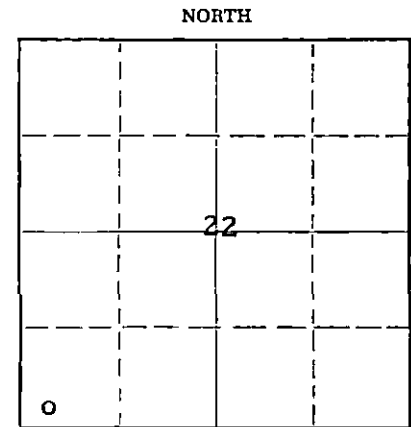

Locate well correctly on above  
Section Plat

Name of Conservation Agent who supervised plugging of this well Eldon Petty

Producing formation \_\_\_\_\_ Depth to top \_\_\_\_\_ Bottom \_\_\_\_\_ Total Depth of Well 3530 Feet

Show depth and thickness of all water, oil and gas formations.

OIL, GAS OR WATER RECORDS

CASING RECORD

FORMATION	CONTENT	FROM	TO	SIZE	PUT IN	PULLED OUT
				8 5/8	250	none

Describe in detail the manner in which the well was plugged, indicating where the mud fluid was placed and the method or methods used in introducing it into the hole. If cement or other plugs were used, state the character of same and depth placed, from \_\_\_\_\_ feet to \_\_\_\_\_ feet for each plug set.

Filled hole to 240' set 1st plug w/25 sx. hulls, 15 sx. cement.

Filled hole to 40' set 2nd plug w/1/2 sack hulls, 10 sx. cement.

(If additional description is necessary, use BACK of this sheet)

Name of Plugging Contractor Murfin Drilling Co.

Address 617 Union Center - Wichita, Kansas

STATE OF Kansas, COUNTY OF Sedgwick, ss.

W. R. Murfin (employee of owner) or (owner or operator) of the above-described well, being first duly sworn on oath, says: That I have knowledge of the facts, statements, and matters herein contained and the log of the above-described well as filed and that the same are true and correct. So help me God.

(Signature) WR Murfin

(Address)

SUBSCRIBED AND SWORN TO before me this 18th day of Jan., 19 57.

My commission expires 6-13-59.

Betty Spriggs  
Notary Public.

PLUGGING  
SEC 22 T. 12 R. 16W  
BLOCK PAGE 135 LINE 43

CONSERVATION DIVISION  
Wichita, Kansas

# WELL LOG


COMPANY Chester Loving & Murfin Drilling Co.

SEC. 22 T. 12 R. 16W  
LOC. SW SW SW

FARM Froelich NO. 1

TOTAL DEPTH 3530  
COMM. 1-5-57 COMP. 1-15-57  
SHOT OR TREATED  
CONTRACTOR Murfin Drilling Co.  
ISSUED

COUNTY Ellis  
KANSAS

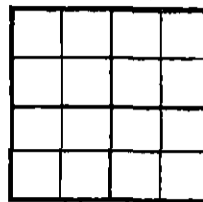

CASING  
20 10  
15 8 @ 250' 3/150 sx.  
12 6  
13 5

ELEVATION 2030 DF

PRODUCTION D & A

FIGURES INDICATE BOTTOM OF FORMATIONS

### TOPS;

550 Shale - Shells  
630 Sand- Shale - Shells  
650 Iron  
740 Sand - Shale - Shells - Iron  
840 Sand  
910 Red Bed  
1184 Red Bed - Shale  
1225 Anhydrite  
1575 Shale - Shells  
1760 Salt - Shale  
1795 Shale - Lime - Shells  
1970 Shale - Lime  
2130 Shale - Lime - Shells  
3405 Lime - Shale  
3519 Lime  
3530 Arbuckle lime  
  
3530 RTD

Anhydrite 1184  
Topeka 2935  
Heebner 3200  
Lansing 3251  
Arbuckle 3519

DST #1 3277-86 1/2 hr.  
8' drlg. mud BHP 730#

DST #2 3401-16 1/2 hr.  
5' drlg. mud BHP 0#

DST #3 3520-30 1/2 hr.  
30 salt water

State of Kansas }  
County of Sedgwick } ss:

RECEIVED  
STATE COMMISSION

FEB 20 1957

CONSERVATION DIVISION  
Wichita, Kansas

I, W. R. Murfin of the Murfin Drilling Company

upon oath state that the above and foregoing is a true and correct copy of the log of the Froelich #1 well.

PLUGGING  
SEC. 22 T. 12 R. 16W  
BOOK PAGE 135 LINE 43

W. R. Murfin

Subscribed and sworn to before me this 18th day of Jan. 19 57.

Commission Expires: 6-13-59.

Betty Spriggs  
NOTARY PUBLIC