

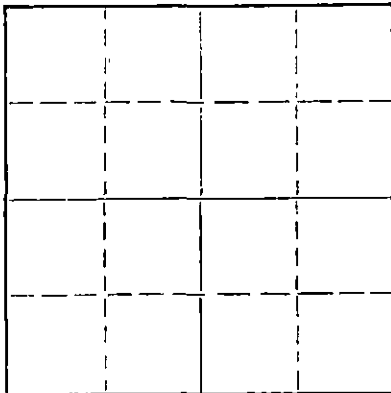
STATE OF KANSAS
STATE CORPORATION COMMISSION

Form CP-4

All Information Completely
Re Required Affidavit
For Deliver Report to:
Conservation Division
State Corporation Commission
211 No. Broadway
Wichita, Kansas

WELL PLUGGING RECORD

NORTH

Locate well correctly on above
Section Plat

Ellis

County. Sec. 14 Twp. 11S Rge. 20W (E) (W)Location as "NE/CNW/SW" or footage from lines NE NE NWLease Owner D & D Drilling Co., Inc., & Chester WilliamsLease Name Davis "B" Well No. 1Office Address 308 Schweiter BuildingCharacter of Well (completed as Oil, Gas or Dry Hole) Dry HoleDate well completed 6-23-63 19Application for plugging filed 6-27-63 19Application for plugging approved 6-23-63 19Plugging commenced 6-23-63 19Plugging completed 6-23-63 19Reason for abandonment of well or producing formation Dry Hole

If a producing well is abandoned, date of last production 19

Was permission obtained from the Conservation Division or its agents before plugging was commenced? YesName of Conservation Agent who supervised plugging of this well Eldon PettyProducing formation Depth to top Bottom Total Depth of Well 3670 Feet

Show depth and thickness of all water, oil and gas formations.

OIL, GAS OR WATER RECORDS

CASING RECORD

FORMATION	CONTENT	FROM	TO	SIZE	PUT IN	PULLED OUT
Surface		0	209	8 5/8"	6-16-63	

Describe in detail the manner in which the well was plugged, indicating where the mud fluid was placed and the method or methods used in introducing it into the hole. If cement or other plugs were used, state the character of same and depth placed, from feet to feet for each plug set.

Filled hole with heavy drilling mud to 500' set.

plug #1 with 20 sacks of cement, plug #2 at

200' with 20 sacks of cement, plug #3 at 40'

with 10 sacks of cement.

RECEIVED
STATE CORPORATION COMMISSION

JUL 1 1963

CONSERVATION DIVISION
Wichita, Kansas

(If additional description is necessary, use BACK of this sheet)

Name of Plugging Contractor D & D Drilling Company, Inc.

Address 308 Schweiter Building, Wichita, KansasSTATE OF Kansas, COUNTY OF Sedgwick, ss.James R. Daniels

(employee of owner) or (owner or operator) of the above-described well, being first duly sworn on oath, says: That I have knowledge of the facts, statements, and matters herein contained and the log of the above-described well as filed and that the same are true and correct. So help me God.

(Signature)

James R. Daniels308 Schweiter Bldg. Wichita, Kansas

(Address)

SUBSCRIBED AND SWORN TO before me this 27th day of June 1963

My commission expires

11-18-66Colleen Chapple
Colleen Chapple

Notary Public.

ROTARY DRILLING LOG

OPERATOR: D & D Drilling Company, Inc. & COMM: 6-15-63
 Chester Williams COMP: 6-24-63

CONTRACTOR: D & D Drilling Company, Inc.

WELL: Davis "B" #1
 NE NE NW Sec. 14-11S-20W
 Ellis County, Kansas

FORMATIONS:REMARKS:

Sand 40'
 Shale 1444'
 Anhydrite 1490'
 Shale 2168'
 Shale & Lime 3058'
 Lime & Shale 3160'
 Lime 3277'
 Lime & Shale 3340'
 Lime 3533'
 Lime & Shale 3630'
 Shale 3640'
 Dolomite 3670'

Set 209' of 8 5/8" surface
 casing at 209', cemented with
 175 sacks of HA-5.

Rotary Total Depth 3670' D & A

RECEIVED
 STATE CORPORATION COMMISSION

JUL 1 1963

CONSERVATION DIVISION
 Wichita, Kansas

A F F I D A V I T

State of Kansas)
) ss
 County of Sedgwick)

James R. Daniels of lawful age, being duly and solemnly sworn
 on oath says: I am a resident of Wichita, Sedgwick County, Kansas, and I
 hereby know and on oath state, that the above drilling log covering the
 Davis "B" No. 1, located in the NE NE NW of Section 14-11S-20W, Ellis
 County, Kansas, is true and correct to the best of my knowledge and belief.
 Further affiant saith not.

D & D DRILLING COMPANY, INC.

James R. Daniels
 James R. Daniels

Subscribed and sworn to before me this 27th day of June, 1963.

My Commission expires 11-18-66

Colleen Chapple
 Colleen Chapple - Notary Public