


WELL PLUGGING RECORD

Give All Information Completely  
Make Required Affidavit  
Mail or Deliver Report to:  
Conservation Division  
State Corporation Commission  
211 No. Broadway  
Wichita, Kansas

NORTH

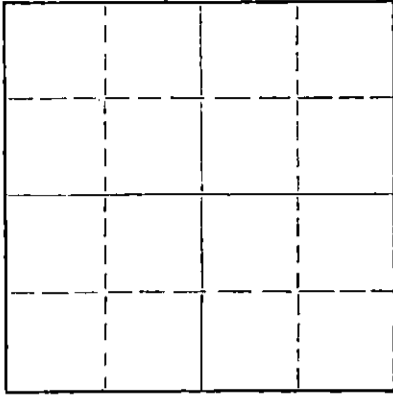

Locate well correctly on above  
Section Plat

Location as "NE/CNW/SW" or footage from lines Ellis County. Sec. 7 Twp. 11 S Rge. 20W (E) (W)

Lease Owner Houston, Chandler, Simpson / Sierra Petroleum - Contr  
Lease Name WALZ Well No. 1

Office Address / 208 Petroleum Co, Wichita, Ks.

Character of Well (completed as Oil, Gas or Dry Hole) Dry

Date well completed 7/29/58 19

Application for plugging filed 7/29/58 19

Application for plugging approved 7/29/58 19

Plugging commenced 7/29/58 19

Plugging completed 7/29/58 19

Reason for abandonment of well or producing formation Dry

If a producing well is abandoned, date of last production \_\_\_\_\_ 19

Was permission obtained from the Conservation Division or its agents before plugging was commenced? yes

Name of Conservation Agent who supervised plugging of this well Eldon M. Petty

Producing formation \_\_\_\_\_ Depth to top \_\_\_\_\_ Bottom \_\_\_\_\_ Total Depth of Well 3700 Feet

Show depth and thickness of all water, oil and gas formations.

OIL, GAS OR WATER RECORDS

CASING RECORD

FORMATION	CONTENT	FROM	TO	SIZE	PUT IN	PULLED OUT
				8 5/8	204	none

Describe in detail the manner in which the well was plugged, indicating where the mud fluid was placed and the method or methods used in introducing it into the hole. If cement or other plugs were used, state the character of same and depth placed, from \_\_\_\_\_ feet to \_\_\_\_\_ feet for each plug set.

PLUGGING RECORD

Plugged hole. Filled hole with heavy mud from 3700 up to 600', wood plug and 20 sacks cement through drill pipe. Fill hole up to 180', bridge w/ 1/3 sks hulls, wood plug and 15 sks cement through drill pipe. Filled hole to 40' with mud bridge w/1/3 sks hulls, wood plug and 10 sks cement. Job completed @ 11:00 a.m. Mr. Petty Hays, Kansas

RECEIVED  
STATE CORPORATION COMMISSION

7-31-58 JUL 31 1958

CONSERVATION DIVISION  
Wichita, Kansas

(If additional description is necessary, use BACK of this sheet)

Name of Plugging Contractor Sierra Petroleum Co., Inc.

Address 208 Petroleum Bldg., Wichita, Kansas

STATE OF KANSAS, COUNTY OF RUSSELL, ss.  
T. R. Sullivan (employee of owner) or (owner or operator) of the above-described

well, being first duly sworn on oath, says: That I have knowledge of the facts, statements, and matters herein contained and the log of the above-described well as filed and that the same are true and correct. So help me God.

(Signature) T. R. Sullivan

(Address)

SUBSCRIBED AND SWORN TO before me this 30th day of July, 19 58

Margie Cooper  
Notary Public.

My commission expires 1-30-61.

PLUGGING  
FILE SEC. 7 T11 20W  
BOOK PAGE 119 LINE 20

Houston - Simpson & Chandler - Owner

Sierra Petroleum Co - Contr.

WALZ #1

SW SW NW 7-11S-20W  
Ellis County, Kansas

Total Depth: 3700'

Elev: 2077 KB

Comm: 7/18/58

Comp: 7/29/58

Casings:

8 5/8 @ 204'

Cement:

with 150 sacks cement

FORMATION	DEPTH
Post Rock & Surface Clay	40
Shale & Sand	125
Shale & shells	590
Shale	645
Sand & Pyrite	745
Shale & shells	1010
Sand	1225
Shale & Red Bed	1304
Red Bed & Sand	1450
Red Bed	1530
Anhydrite	1565
Shale & Shells	1900
Salt & Shale	2060
Shale & Lime	3385
Lime	3479
Lime & Chert	3510
Lime	3605
Conglomerate	3671
Lime	3700

Tops:	DEPTH
Anhydrite	1530
Topeka	3120
Heebner	3331
Lansing K. C.	3370
Base K. C.	3572
Conglomerate	3625
Arbuckle	3677

STATE OF KANSAS )  
                          ) ss:  
COUNTY OF RUSSELL )

I hereby certify that the above information is true and correct to the best of my knowledge.

T.R. Sullivan

Subscribed and sworn to before me this 30th day of July, 1958.

Margie Cooper  
Notary Public

My commission expires: 1-30-61.

RECEIVED  
STATE CORPORATION COMMISSION

JUL 31 1958

INFORMATION DIVISION  
Kansas

PLUGGING  
FILE SEC 7 T. 11 R. 20W  
BOOK PAGE 119 LINE 20