


WELL PLUGGING RECORD

Information Completely
Required Affidavit
Deliver Report to:
Conservation Division
State Corporation Commission
212 No. Market
Wichita, Kansas

Ellis County, Sec. 29 Twp. 11S Rge. ~~18~~ 18 (W)

Location as "NE/CNWxSWx" or footage from lines SW NE SE
Lease Owner Champlin Petroleum Company
Lease Name Johnson "E" Well No. 3
Office Address P. O. Box 308, Ellinwood, Kansas
Character of Well (completed as Oil, Gas or Dry Hole) Dry Hole
Date well completed August 1 19 69
Application for plugging filed August 6 19 69
Application for plugging approved (Verbal) August 1 19 69
Plugging commenced August 2 19 69
Plugging completed August 2 19 69
Reason for abandonment of well or producing formation

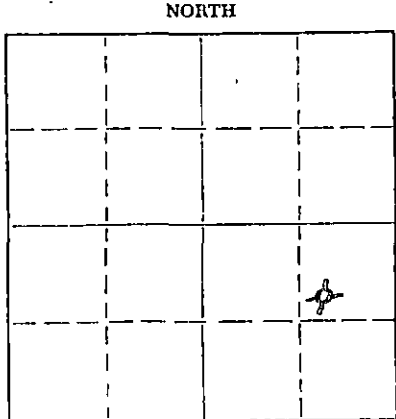

Locate well correctly on above Section Plat

If a producing well is abandoned, date of last production 19
Was permission obtained from the Conservation Division or its agents before plugging was commenced? Yes

Name of Conservation Agent who supervised plugging of this well Leo Massey
Producing formation Depth to top Bottom Total Depth of Well 3504 Feet
Show depth and thickness of all water, oil and gas formations.

OIL, GAS OR WATER RECORDS

CASING RECORD

FORMATION	CONTENT	FROM	TO	SIZE	PUT IN	PULLED OUT
				8 5/8" OD	215	None

Describe in detail the manner in which the well was plugged, indicating where the mud fluid was placed and the method or methods used in introducing it into the hole. If cement or other plugs were used, state the character of same and depth placed, from feet to feet for each plug set.

Pushed plug to 600', mixed and pumped 70 sacks 50/50 pozmix with 4% added gel. Mixed and pumped 20 sacks 50/50 pozmix with 4% added gel at 210', filled hole with mud to 40', pushed plug and 1/2 sack of hulls to 40' and mixed and pumped 10 sacks 50/50 pozmix filling hole to bottom of cellar.

Plugging completed at 3:15 a.m. August 2, 1969.

RECEIVED
STATE CORPORATION COMMISSION
AUG 8 1969
CONSERVATION DIVISION
Wichita, Kansas

(If additional description is necessary, use BACK of this sheet)
Name of Plugging Contractor Red Tiger Drilling Company
Address 1720 Wichita Plaza, Wichita, Kansas

STATE OF Kansas, COUNTY OF Barton, ss.
J. W. Meyers (employee of owner) or (owner or operator) of the above-described well, being first duly sworn on oath, says: That I have knowledge of the facts, statements, and matters herein contained and the log of the above-described well as filed and that the same are true and correct. So help me God.

(Signature) J. W. Meyers, District Operations Mgr.
P. O. Box 308, Ellinwood, Kansas
(Address)

SUBSCRIBED AND SWORN TO before me this 6th day of August, 19 69

My commission expires 5/22/70

N. Kenneth Stivers
Notary Public.