

STATE OF KANSAS
STATE CORPORATION COMMISSION

WELL PLUGGING RECORD


OR

FORMATION PLUGGING RECORD

Strike out upper line when reporting plugging of formations.

Give All Information Completely
Make Required Affidavit
Mail or Deliver Report to:
Conservation Division
State Corporation Commission
800 Bitting Building
Wichita, Kansas

NORTH

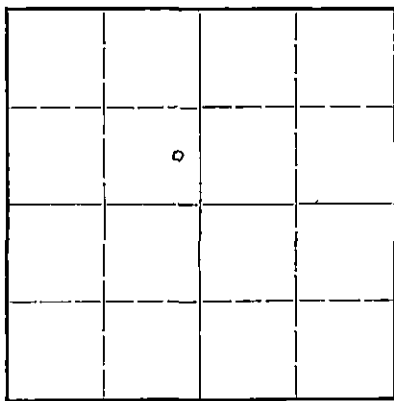

Locate well correctly on above Section Plat

Ellis County. Sec. 22 Twp. 11 Rge. (E) 18 (W)
Location as "NE 1/4 NW 1/4 SW 1/4" or footage from lines. Center 1/2 SE NW
Lease Owner. Lario Oil & Gas Company
Lease Name. Henderson Well No. 1 "F"
Office Address. 301 South Market, Wichita, Kansas
Character of Well (completed as Oil, Gas or Dry Hole). Dry
Date well completed. October 8, 19 46
Application for plugging filed. November 4, 19 46
Application for plugging approved. November 4, 19 46
Plugging commenced. November 4, 19 46
Plugging completed. November 10, 19 46
Reason for abandonment of well or producing formation. Dry Hole

If a producing well is abandoned, date of last production. 19...
Was permission obtained from the Conservation Division or its agents before plugging was commenced? Yes

Name of Conservation Agent who supervised plugging of this well. H. W. Kerr
Producing formation. Depth to top. Bottom. Total Depth of Well. 3520 Feet
Show depth and thickness of all water, oil and gas formations.

OIL, GAS OR WATER RECORDS

CASING RECORD

Formation	Content	From	To	Size	Put In	Pulled Out
				12 1/2"	159'	None
				8 5/8"	1221'	None
				5 1/2"	3519'	2630'

Describe in detail the manner in which the well was plugged, indicating where the mud fluid was placed and the method or methods used in introducing it into the hold. If cement or other plugs were used, state the character of same and depth placed, from...feet to...feet for each plug set.

Set Lane Wells plug at 3225', perforated at 3077', filled hole with mud from 3225' to 3075', set rock bridge, dumped 5 sacks cement, filled hole with mud from 3000' to 350', set 10' rock bridge at 350', dumped 15 sacks cement, filled with mud to 15' of top, dumped 10 sacks for cap in cellar.

Stamp: FILED 22 11 1846
NOV 28 1946


(If additional description is necessary, use BACK of this sheet)

Correspondence regarding this well should be addressed to Lario Oil & Gas Company
Address. 301 South Market
Wichita, Kansas

STATE OF Kansas, COUNTY OF Sedgwick
Leo Ross (employee of owner) or (owner or operator) of the above-described well,

being first duly sworn on oath, says: That I have knowledge of the facts, statements, and matters herein contained and the log of the above-described well as filed and that the same are true and correct. So help me God

(Signature)

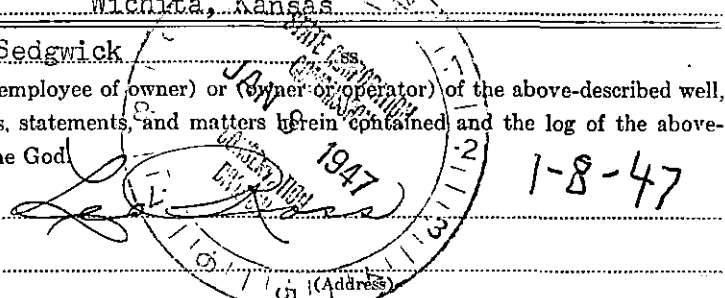

SUBSCRIBED AND SWORN to before me this 7th day of January, 19 47.

My commission expires

Dec. 28, 1949.

Notary Public.

Real Dept
Lario

F. HENDERSON #1

C. E. 1/2 SE 1/4 NW 1/4 Section 22-11S-18W

ELLIS COUNTY, KANSAS

LARIO OIL AND GAS COMPANY

Dry

Commenced: September 15, 1946
Completed: October 7, 1946

Shale	0	25
Gravel	25	40
Shale	40	105
Shale & Lime Shells	105	159
Shale & Shells	159	360
Sand	360	425
Red Shale	425	488
Sand	488	627
Shale	627	685
Lime & Shale	685	830
Lime	830	950
Red Bed	950	1110
Red Bed & Shale	1110	1193
Anhydrite	1193	1225
Red Bed	1225	1275
Shale & Shells	1275	1375
Lime & Shale Broken	1375	1498
Salt & Streaks Shale	1498	1630
Shale & Shells	1630	1650
Lime & Shale	1650	1781
Lime, Shale & Shells	1781	1942
Shale & Lime	1942	2105
Broken Lime	2105	2227
Lime & Shale	2227	2395
Lime	2395	2470
Lime & Shale	2470	2960
Shale	2960	2975
Lime & Shale	2975	3075
Cherty Lime	3075	3077
Lime & Shale	3077	3130
Lime, Shale & Pyrite	3130	3157
Lime	3157	3255
Lime & Shale	3255	3431
Cherty Lime	3431	3439
Lime & Shale, Cherty Lime	3439	3456
Shale, Lime & Chert	3456	3478
Lime	3478	3487
Lime & Shale, Cherty Lime	3487	3502
Lime, Shale & Chert	3502	3517
Lime	3517	3520

CASING RECORD

12-1/2" casing set at 159' and cemented with bulk cement.

8-5/8" casing set at 1221' and cemented with 500 sacks bulk cement.

5-1/2" casing set at 3519' and cemented with 150 sacks of bulk cement.

Recovered 2630' of 5/2"

FORMATIONS

Topeka	2890
Lansing	3155
SSO	3203-3207
Base Kansas City	3400
Conglomerate	3412
Simpson	3458
Arbuckle	3473
Pay	3474-3478
Total Depth	3520

TOTAL DEPTH 3520

STATE OF KANSAS)
) ss
COUNTY OF SEDGWICK)

22 11 18W
83 28



I hereby affirm that the above and foregoing is a true and correct copy of the log of your F. Henderson #1 well, located in the East half of the Southeast Quarter of the Northwest Quarter of Section 22, Township 11 South, Range 18 West, Ellis County, Kansas.

LOWELL DRILLING COMPANY, INC.

By Emil C. Bowers
Secretary-Treasurer

Subscribed and sworn to before me, a Notary Public, this 10th day of October, 1946.

Pauline Harris
Notary Public

My commission expires May 27, 1950.