

WELL PLUGGING RECORD

STATE OF KANSAS  
STATE CORPORATION COMMISSION


FORMATION PLUGGING RECORD

Give All Information Completely  
Make Return Affidavit  
Mail or Deliver Report to:  
Conservation Division  
State Corporation Commission  
800 Bittling Building  
Wichita, Kansas

Strike out upper line  
when reporting plug-  
ging of formations.

Stafford County, Sec. 4- Twp. 21 Rge. (E) 12 (W)

Location as "NE 1/4 NW 1/4 SW 1/4" or footage from lines NW NW SW  
Lease Owner G W Keyes Drilling Co. et al  
Lease Name Hewitt Well No. 1  
Office Address Ellinwood, Kansas  
Character of Well (completed as Oil, Gas or Dry Hole) Dry hole  
Date well completed March 26, 1949 19  
Application for plugging filed April 16, 1949 19  
Application for plugging approved April 16, 1949 19  
Plugging commenced April 16, 1949 19  
Plugging completed April 20, 1949 19  
Reason for abandonment of well or producing formation Dry Hole

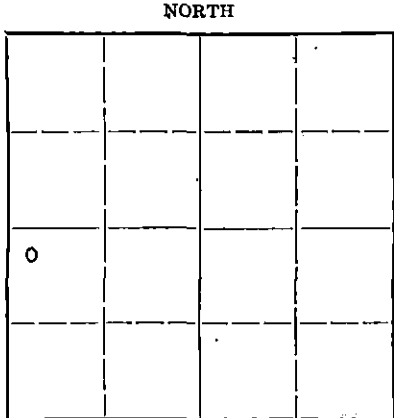

Locate well correctly on above  
Section Plat

If a producing well is abandoned, date of last production none 19  
Was permission obtained from the Conservation Division or its agents before plugging was com-  
menced? YES

Name of Conservation Agent who supervised plugging of this well C. D. Stough  
Producing formation - - - Depth to top - - - Bottom - - - Total Depth of Well 3477 Feet  
Show depth and thickness of all water, oil and gas formations.

OIL, GAS OR WATER RECORDS

CASING RECORD

Formation	Content	From	To	Size	Put In	Pulled Out
Surface pipe	258'	0	258	8 5/8"	258'	none
Long string	3443	0	3443	5 1/2"	3443	3220

Describe in detail the manner in which the well was plugged, indicating where the mud fluid was placed and the method or methods used in introducing it into the hold. If cement or other plugs were used, state the character of same and depth placed, from...feet to...feet for each plug set.

Ran 5 sacks cement on Lane Wells plug at 3254'. Filled with heavy mud to 250'. Ran 15 sacks cement. Filled with heavy mud to 10'. Cemented with 10 sacks on top, cement returning to base of cellar.

RECEIVED  
Conservation Div.  
APR 27 1949  
STATE CORPORATION  
COMMISSION  
KANSAS

(If additional description is necessary, use BACK of this sheet)

Correspondence regarding this well should be addressed to G. W. Keyes Drilling Company  
Address Ellinwood, Kansas

STATE OF Kansas, COUNTY OF Barton, ss.  
Edw. H. Isern, Part Owner

being first duly sworn on oath, says: That I have knowledge of the facts, statements, and matters herein contained and the log of the above-described well as filed and that the same are true and correct. So help me God.

(Signature) Edw H Isern

Ellinwood, Kansas  
(Address)

SUBSCRIBED AND SWORN TO before me this 26th day of April, 1949, 19

Sergeant A. Meyer  
Notary Public.

My commission expires Feb. 10, 1951

PLUGGING  
FILE SEC 4 T 21 R 14 W  
BOOK PAGE 91 LINE 43

WELL LOG

G. W. KEYES DRILLING COMPANY et al, OWNERS - HEWITT # 1  
NW/4 NW/4 SW/4 Section 4, Township 21; Range 12 W  
Stafford County, Kansas

Elevation: 1849' DF.

Figures indicate bottom of formation  
0 to 235 surface sand and clay

Pipe Record:

8 5/8" set at 258'  
5 1/2" set at 3443'

258 shale  
640 red bed  
668 anhydrite  
1115 shale and shells  
1470 salt, shale and shells  
1680 shale and shells  
1890 lime, shale and sand  
1985 sand, lime and shale  
2800 lime and shale  
2990 lime  
3390 lime and shale  
3415 lime  
3441 conglomerate  
3449 arbuckle  
3449 Total Rotary Depth

Tops, Rotary Bushing measurement

Anhydrite 640  
Heebner 2955  
Brown Lansing 3181  
Lansing 3204  
Conglomerate 3415  
Arbuckle 3441

Rotary Commenced 3-8-49  
completed 3-18-49

CABLE TOOL WORK

Cable Tools commenced 3-21-49  
completed 3-26-49

Moved in cable tool, bailed hole, drilled cement and  
cleaned out hole to total rotary depth. Drilled  
deeper.

3477 arbuckle  
3477 Total Depth D & A

STATE OF KANSAS )  
COUNTY OF BARTON ) SS.

I, G. W. Keyes, Part Owner, of the above-described well, being first duly sworn on oath,  
declare: That I have knowledge of the facts, statements and matters herein contained  
pertaining to the log of the above-described well, as filed, and that the same are  
true and correct.

*G. W. Keyes*

Subscribed and Sworn to before me this 15th day of April, 1949.

*George A. Meyer*  
Notary Public

My commission expires Feb. 10, 1951.

PLUGGING  
FILE SEC 4 T 21 R 12 W  
DATE 9/11/49

APR 18 1949  
STATE CORPORATION  
COMMISSION  
KANSAS