

Give All Information Completely
Make Required Affidavit
Mail or Deliver Report to:
Conservation Division
State Corporation Commission
212 No. Market
Wichita, Kansas

WELL PLUGGING RECORD

Stafford County, Sec. 4 Twp. 21S Rge. (E) 12 (W)

Location as "NE/CNW/SW" or footage from lines SE NW NE

Lease Owner L. K. Parrish & Yarnell

Lease Name Spacil Well No. 9

Office Address 714 Fourth National Bank Bldg., Wichita, Kansas

Character of Well (completed as Oil, Gas or Dry Hole) oil

Date well completed _____ 19 _____

Application for plugging filed September 22 19 66

Application for plugging approved _____ 19 _____


Plugging commenced September 27 19 66

Plugging completed October 1 19 66

Reason for abandonment of well or producing formation depleted

If a producing well is abandoned, date of last production _____ 19 _____

Was permission obtained from the Conservation Division or its agents before plugging was commenced? yes

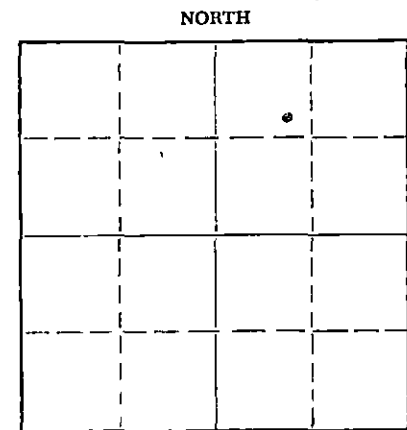

Locate well correctly on above Section Plat

Name of Conservation Agent who supervised plugging of this well Archie Elving

Producing formation _____ Depth to top _____ Bottom _____ Total Depth of Well 3450 Feet

Show depth and thickness of all water, oil and gas formations.

OIL, GAS OR WATER RECORDS


CASING RECORD

FORMATION	CONTENT	FROM	TO	SIZE	PUT IN	PULLED OUT
		0	252'	8 5/8"	252'	none
		0	3442'	5 1/2"	3442'	2503.85

Describe in detail the manner in which the well was plugged, indicating where the mud fluid was placed and the method or methods used in introducing it into the hole. If cement or other plugs were used, state the character of same and depth placed, from _____ feet to _____ feet for each plug set.

Pushed plug to 3300', set 10' rock bridge and dumped 5 sacks of cement.

Pushed plug to 240', set 10' rock bridge and dumped 4 sacks of cement for over night plug. Bailed hole down and dumped 21 sacks of cement. Filled hole with mud to 40', set 10' rock bridge and capped hole with 10 sacks of cement.

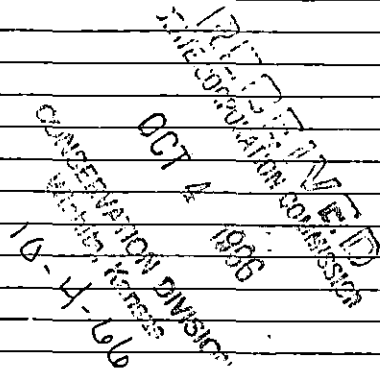

(If additional description is necessary, use BACK of this sheet)

Name of Plugging Contractor Pipe Pullers, Inc.

Address Box 486, Ellinwood, Kansas

STATE OF Kansas, COUNTY OF Barton, ss. Dean Wells

(employee of owner) or (owner or operator) of the above-described well, being first duly sworn on oath, says: That I have knowledge of the facts, statements, and matters herein contained and the log of the above-described well as filed and that the same are true and correct. So help me God.

(Signature) Dean Wells

Ellinwood, Kansas

(Address)

SUBSCRIBED AND SWORN to before me this 3rd day of October, 19 66

J. J. Rader

My commission expires July 7, 1968

Notary Public.

DRILLERS LOGSPACIL NO. 9

CASING RECORD:	COMPANY: Parrish & Yarnell	DESCRIPTION:
8-5/8" @ 252' w/200 sax cement	CONTRACTOR: Sage Drilling Co.	SE NW NE Sec. 4-21S-12W Stafford Co., Kansas
TOTAL DEPTH: 3450'	COMMENCED: July 11, 1966	ELEVATION: 1845KB
	COMPLETED: July 17, 1966	

<u>FORMATION</u>	<u>FROM</u>	<u>TO</u>	<u>REMARKS</u>
Surface Soil	0	253	
Shale	253	304	
Red Bed & Shale	304	617	
Anhydrite	617	642	
Shale	642	1465	
Lime & Shale	1465	2085	
Shale & Shells	2085	2515	
Lime & Shale	2515	3436	
Lime	3436	3450	

RECEIVED
STATE CORPORATION COMMISSION

OCT 4 1966

CONSERVATION DIVISION
WILLIAM P. FORBES

I certify that this is a true and correct copy of the above log to the best of my knowledge.

SAGE DRILLING COMPANY, INC.

By Lawrence F. Gray
Lawrence F. Gray

Subscribed and sworn to before me this 22nd day of July, 1966.

Louise K. Whitted
Louise K. Whitted, Notary Public

My commission expires:
November 26, 1966.