

STATE OF KANSAS
STATE CORPORATION COMMISSION

Form CP-4

WELL PLUGGING RECORD

- Give All Information Completely
- Make Required Affidavit
- Mail or Deliver Report to:
Conservation Division
State Corporation Commission
211 No. Broadway
Wichita, Kansas

Stafford County, Sec. 4 Twp. 21S Rge. 12W (E) (W)

Location as "NE/CNW/SW" or footage from lines NW SW SE

Lease Owner L. K. Parrish

Lease Name Hewitt Well No. 1

Office Address 714 Fourth Natl Bank Bldg., Wichita, Kansas

Character of Well (completed as Oil, Gas or Dry Hole) dry hole

Date well completed 9/20/65 19

Application for plugging filed " 19

Application for plugging approved " 19


Plugging commenced " 19

Plugging completed " 19

Reason for abandonment of well or producing formation too low structurally

If a producing well is abandoned, date of last production 19

Was permission obtained from the Conservation Division or its agents before plugging was commenced? yes

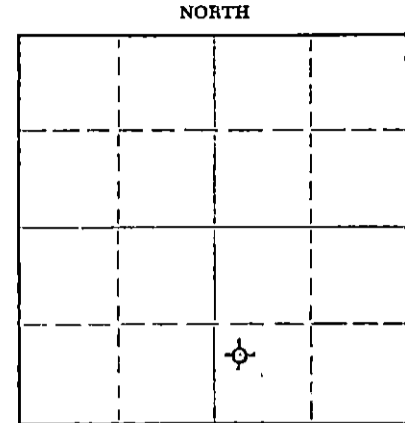

Locate well correctly on above Section Plat

Name of Conservation Agent who supervised plugging of this well Archie V Elving

Producing formation Depth to top Bottom Total Depth of Well Feet

Show depth and thickness of all water, oil and gas formations.

OIL, GAS OR WATER RECORDS

CASING RECORD

FORMATION	CONTENT	FROM	TO	SIZE	PUT IN	PULLED OUT
				8-5/8"	254.3	none

Describe in detail the manner in which the well was plugged, indicating where the mud fluid was placed and the method or methods used in introducing it into the hole. If cement or other plugs were used, state the character of same and depth placed, from feet to feet for each plug set.

FILLED HOLE WITH HEAVY MUD TO 225'. SET PLUG WITH 25 SACKS CEMENT.
FILLED HOLE WITH HEAVY MUD TO 40'. SET PLUG AND FILLED TO TOP WITH
3/4 SX HULLS AND 10 SX CEMENT.

RECEIVED
STATE CORPORATION COMMISSION

NOV 1 1965

CONSERVATION DIVISION
Wichita, Kansas

(If additional description is necessary, use BACK of this sheet)

Name of Plugging Contractor C-G Drilling Co.
Address 107 Rule Building, Wichita, Kansas


STATE OF KANSAS, COUNTY OF SEDGWICK, ss. Jay H. Galloway (employee of owner) or (owner) of the above-described well, being first duly sworn on oath, says: That I have knowledge of the facts, statements, and matters herein contained and the log of the above-described well as filed and that the same are true and correct. So help me God.

(Signature) Jay H Galloway
107 Rule Bldg., Wichita, Kansas (Address)

Subscribed and Sworn to before me this 21 day of September, 19 65

My commission expires May 20, 1967

Vicky Jacobs Notary Public.

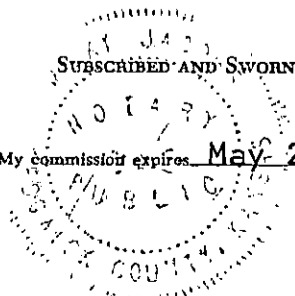

W E L L L O G

OPERATOR: L. K. PARRISH
 WELL NAME: HEWITT #1 LOCATION: NW SW SE Sec. 4-21-12W
 COUNTY: STAFFORD STATE: KANSAS
 WELL COMMENCED: 9/11/65 WELL COMPLETED: 9/20/65
 ELEVATION: 1841 K.B. TOTAL DEPTH: 3492'
 PRODUCTION: Dry & abandoned RIG NO: 2
 CASING - 8-5/8": 254.30' (6 jts.) with 360 sacks Quikset cement
 5-1/2": _____

All Measurements taken from the top of rotary bushing.

FROM	TO	FORMATION	DEVIATION FROM VERTICAL	REMARKS:
0	220	Sand		
220	635	Red Bed	500' - 1/4°	
635	665	Anhydrite		
665	1475	Shale-Shells	1000' - 1/4°	
1475	3040	Lime-Shale		DST 1: 3364-78
3040	3492	Lime	2000' - 1/2°	DST 2: 3474-78 DST 3: 3479-92

RECEIVED
STATE CORPORATION COMMISSION

NOV 1 1965

CONSERVATION DIVISION
Wichita, Kansas

STATE OF KANSAS)
COUNTY OF SEDGWICK) SS:

The undersigned hereby certifies that to the best of his knowledge and belief, the above facts are true and correct.

C-G DRILLING CO.

By Jay H. Gall

SUBSCRIBED AND SWORN TO, BEFORE ME, This 21 day of September, 1965.

My comm. exp: May 20, 1967

Vicky Jacobs
Vicky Jacobs - Notary Public

