


STATE OF KANSAS  
STATE CORPORATION COMMISSION

WELL PLUGGING RECORD

Give All Information Completely  
Make Required Affidavit  
Mail or Deliver Report to:  
Conservation Division  
State Corporation Commission  
800 Bittling Building  
Wichita, Kansas

Stafford County, Sec. 4 Twp. 21 Rge. 12 (W)  
Location as "NE/CNW $\frac{1}{4}$ /SW $\frac{1}{4}$ " or footage from lines NW NE SE  
Lease Owner Duke and Wood Drilling Company, Inc.  
Lease Name Hewitt Well No. 1  
Office Address P. O. Box 194, Great Bend, Kansas  
Character of Well (completed as Oil, Gas or Dry Hole) Dry Hole  
Date well completed April 24, 1950  
Application for plugging filed April 24, 1950  
Application for plugging approved April 24, 1950  
Plugging commenced April 24, 1950  
Plugging completed April 24, 1950  
Reason for abandonment of well or producing formation Dry

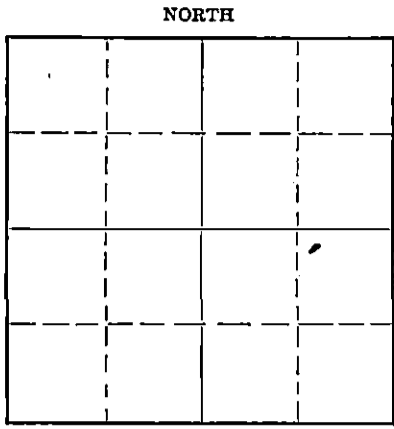

Locate well correctly on above  
Section Plat

If a producing well is abandoned, date of last production 19...  
Was permission obtained from the Conservation Division or its agents before plugging was commenced? Yes

Name of Conservation Agent who supervised plugging of this well Mr. C. D. Stough  
Producing formation Depth to top Bottom Total Depth of Well 3492 Feet  
Show depth and thickness of all water, oil and gas formations.

OIL, GAS OR WATER RECORDS

CASING RECORD

Formation	Content	From	To	Size	Put In	Pulled Out
				8 5/8"	283	None

Describe in detail the manner in which the well was plugged, indicating where the mud fluid was placed and the method or methods used in introducing it into the hole. If cement or other plugs were used, state the character of same and depth placed, from feet to feet for each plug set.

Filled with heavy mud to 283'. Set plug at 283' and mixed fifteen (15) sacks of cement and displaced through drill pipe on same. Filled hole with heavy mud to 30 ft. Set plug @ 30 ft. Ten (10) sacks of cement dumped on same filled to bottom of cellar.

(If additional description is necessary, use BACK of this sheet)


Correspondence regarding this well should be addressed to Duke and Wood Drilling Company, Inc.  
Address P. O. Box 194, Great Bend, Kansas

STATE OF Kansas, COUNTY OF Barton, ss.  
Lynn O. Duke, (owner or operator) of the above-described well,  
being first duly sworn on oath, says: That I have knowledge of the facts, statements, and matters herein contained and the log of the above-described well as filed and that the same are true and correct. So help me God.

(Signature) *Lynn O. Duke*  
Great Bend, Kansas  
P. O. Box 194, Great Bend, Kansas (Address)

SUBSCRIBED AND SWORN to before me this 1st day of May, 1950.  
Notary Public. *Dean E. Cooley*  
MAY 3 - 1950

My commission expires April 29, 1953

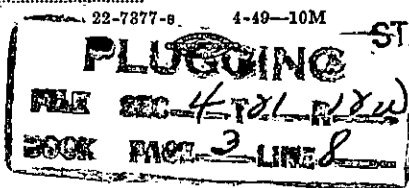

STATE CORPORATION COMMISSION KANSAS

15.185.11511.0000

WELL LOG  
Hewitt No. 1  
NW NE SE Sec. 4-21-12W  
Stafford County

0 to 200	Sand	2285 to 2290	Lime
200 to 225	Gumbo and Red Bed	2290 to 2310	Shale and lime
225 to 240	Red Bed	2310 to 2490	Shale and shells
240 to 250	Sand	2490 to 2500	Lime
250 to 280	Red Bed	2500 to 2535	Shale
280 to 283	Red Bed and shells	2535 to 2552	Shale
283 to 295	Red bed and shells	2552 to 2655	Shale and lime (rough)
295 to 305	Sand	2655 to 2700	Shale and lime
305 to 345	Red Bed	2700 to 2715	Lime
345 to 430	Red Bed and sand streaks	2715 to 2785	Lime and Shale
430 to 450	Sand	2785 to 2832	Lime and shale
450 to 475	Shale	2832 to 2870	Lime
475 to 485	Shale	2870 to 2915	Lime
485 to 610	Red bed and sand	2915 to 2990	Lime
610 to 620	Red bed and clay	2990 to 3045	Lime
620 to 624	Chalk	3045 to 3100	Lime
624 to 653	Anhydrite	3100 to 3175	Lime
653 to 680	Shale and shells	3175 to 3215	Lime
680 to 755	Red Bed	3215 to 3270	Lime
755 to 855	Blue shale and red bed	3270 to 3315	Lime
855 to 1145	Shale and red bed	3315 to 3355	Lime
1145 to 1180	Salt	3355 to 3395	Lime
1180 to 1210	Salt	3395 to 3410	Lime
1210 to 1300	Shale and shells	3410 to 3440	Lime
1300 to 1370	Shale and lime streaks	3440 to 3492	Lime
1370 to 1430	Shale and shells		
1430 to 1440	Shale and lime		
1440 to 1545	Shale and shells		
1545 to 1680	Shale and Anhydrite shells		
1680 to 1730	Shale and shells		
1730 to 1770	Shale		
1770 to 1810	Shale and lime		
1810 to 1817	Shale and lime		
1817 to 1827	Lime		
1827 to 1830	Shale and lime		
1830 to 1864	Shale and red rock		
1864 to 1875	Shale and lime		
1875 to 1995	Shale and lime		
1995 to 2010	Shale and lime		
2010 to 2040	Lime		
2040 to 2105	Lime and shale		
2105 to 2165	Lime and shale		
2165 to 2175	Lime and shale and red rock		
2175 to 2195	Lime and shale		
2195 to 2200	Lime		
2200 to 2220	Shale		
2220 to 2285	Lime and shale		

TOTAL ROTARY DEPTH

DATE COMMENCED: April 13, 1950

DATE COMPLETED: APRIL 24, 1950

T O P S

Elevation	1845'	R.B.
Heebner	3056'	
Brown Lansing	3175'	
Lansing	3196'	
Conglomerate	3424'	
Simpson Shale	3469'	
Simpson Sand	3471'	
Arbuckle	3482'	

MAY 3, 1950

DUKE AND WOOD DRILLING COMPANY, INC.

*Lynn O. Duke*

**PLUGGING**  
FILE SEC. 4-21-12W  
BOOK PAGE 3 LINE 8