


STATE OF KANSAS  
STATE CORPORATION COMMISSION

Give All Information Completely  
Make Required Affidavit  
Mail or Deliver Report to:  
Conservation Division  
State Corporation Commission  
212 No. Market  
Wichita, Kansas

WELL PLUGGING RECORD

NORTH

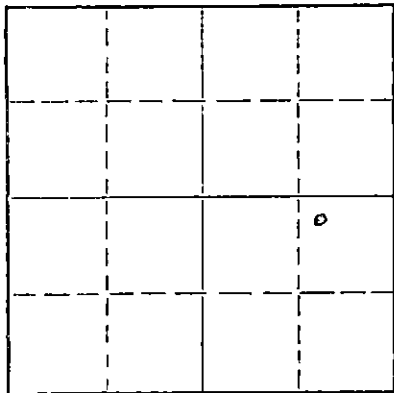

Locate well correctly on above  
Section Plat

Stafford County. Sec. 15 Twp. 21 Rge. 13 (X) West (W)  
Location as "NE/CNW%SW%" or footage from lines NW NE SE  
Lease Owner Icer Addis  
Lease Name HERB Well No. 1  
Office Address Box 519 - Great Bend, Ks.  
Character of Well (completed as Oil, Gas or Dry Hole) dry hole  
Date well completed May 22 19 69  
Application for plugging filed May 22 19 69  
Application for plugging approved May 22 19 69  
Plugging commenced May 22 19 69  
Plugging completed May 22 19 69  
Reason for abandonment of well or producing formation \_\_\_\_\_

If a producing well is abandoned, date of last production \_\_\_\_\_ 19\_\_\_\_  
Was permission obtained from the Conservation Division or its agents before plugging was commenced? yes

Name of Conservation Agent who supervised plugging of this well Ralph Warren  
Producing formation \_\_\_\_\_ Depth to top \_\_\_\_\_ Bottom \_\_\_\_\_ Total Depth of Well 3660 Feet  
Show depth and thickness of all water, oil and gas formations.

OIL, GAS OR WATER RECORDS

CASING RECORD

FORMATION	CONTENT	FROM	TO	SIZE	PUT IN	PULLED OUT

Describe in detail the manner in which the well was plugged, indicating where the mud fluid was placed and the method or methods used in introducing it into the hole. If cement or other plugs were used, state the character of same and depth placed, from \_\_\_\_\_ feet to \_\_\_\_\_ feet for each plug set.

Hole full heavy mud -  
At 450' - pumped 50 sacks cement thru drill pipe  
Come up to 250' - pumped 25 sacks cement thru d.p.  
Come up to 40' - Set plug - good bridge - pumped 10 sacks cement  
2 sacks cement in rat hole

RECEIVED  
STATE CORPORATION COMMISSION  
MAY 23 1969  
CONSERVATION DIVISION  
Wichita, Kansas

(If additional description is necessary, use BACK of this sheet)

Name of Plugging Contractor \_\_\_\_\_  
Address \_\_\_\_\_

STATE OF KANSAS, COUNTY OF BARTON, ss.  
Larry Curtis (employee of owner) or (~~owner~~) of the above-described well, being first duly sworn on oath, says: That I have knowledge of the facts, statements, and matters herein contained and the log of the above-described well as filed and that the same are true and correct. So help me God.

(Signature) Larry Curtis  
Box 823 - Great Bend, Kansas  
(Address)

SUBSCRIBED AND SWORN TO before me this 22nd day of May, 19 69

Alonzo M. Hogue  
Notary Public.

My commission expires 4-11-70

W E L L      L O G

DATE COMMENCED: May 14, 1969  
 DATE COMPLETED: May 22, 1969

Icer Addis  
 HERB #1  
 NW/4 NE/4 SE/4  
 Sec. 15-21-13w  
 Stafford County, Kansas

0 - 74' Sand & Clay  
 74 - 150' Hard Sand  
 150 - 240' Clay  
 240 - 290' Hard Sand  
 290 - 345' Clay & Shale  
 345 - 738' Red Bed  
 738 - 761' Anhydrite  
 761 - 1600' Shale & Shells  
 1600 - 2270' Lime & Shale  
 2270 - 2560' Shale & Lime  
 2560 - 2985' Lime & Shale  
 2985 - 3170' Lime  
 3170 - 3175' Heebner - Shale  
 3175 - 3191' Lime & Shale  
 3191 - 3206' Lime  
 3206 - 3299' Shale  
 3299 - 3314' Lime & Shale  
 3314 - 3531' Lime  
 3531 - 3547' Shale  
 3547 - 3575' Conglomerate  
 3575 - 3588' Viola  
 3588 - 3594' Shale  
 3594 - 3660' Conglomerate

ELEVATION: 1882' K.B.

FORMATION DATA	
Anhydrite	738
Heebner	3170
Toronto	3191
Douglas	3206
Brown Lime	3299
Kansas City	3314
Base K.C.	3531
Conglomerate	3547
Viola	3574
Simp. Shale	3588
RTD	3660

SURFACE PIPE: Set new  
 8-5/8" at 371' with 225  
 sacks cement.

RECEIVED  
 STATE CORPORATION COMMISSION  
 MAY 23 1969  
 CONSERVATION DIVISION  
 Wichita, Kansas

A F F I D A V I T

STATE OF KANSAS  
 COUNTY OF BARTON ) ss.

Larry Curtis of lawful age, does swear and state that  
 the facts and statements herein contained are true and correct to the  
 best of his knowledge.

Larry Curtis

Subscribed and sworn to before me this 22 day of May, 1969

My Comm. Expires:  
4-11-70

Kleerchy M. Hague  
 Notary Public