


STATE OF KANSAS
STATE CORPORATION COMMISSION

Form CP-4

Give All Information Completely
Make Required Affidavit
Mail or Deliver Report to:
Conservation Division
State Corporation Commission

WELL PLUGGING RECORD

P. O. Box 17027
Wichita, Kansas 67217
NORTH

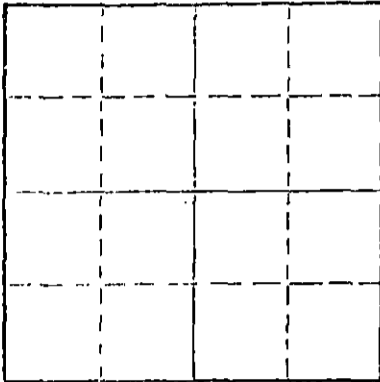

Locate well correctly on above
Section Plat

Stafford County. Sec. 15 Twp. 21S. Rge. (E) 13 (W)
Location as "NE/CNWxSW!" or footage from lines SW SE SE
Lease Owner John C. Bannister and William L. Carey
Lease Name Herb Well No. 1
Office Address 5512 Plaza Lane, Wichita, Kansas
Character of Well (completed as Oil, Gas or Dry Hole) Dry Hole
Date well completed Aug. 4 19 74
Application for plugging filed Aug. 4 19 74
Application for plugging approved Aug. 4 19 74
Plugging commenced Aug. 4 19 74
Plugging completed Aug. 4 19 74
Reason for abandonment of well or producing formation Dry

If a producing well is abandoned, date of last production 19____
Was permission obtained from the Conservation Division or its agents before plugging was commenced? Yes

Name of Conservation Agent who supervised plugging of this well G. R. Biberstein
Producing formation _____ Depth to top _____ Bottom _____ Total Depth of Well 3688 Feet
Show depth and thickness of all water, oil and gas formations.

OIL, GAS OR WATER RECORDS

CASING RECORD

FORMATION	CONTENT	FROM	TO	SIZE	PUT IN	PULLED OUT
				8 5/8	289	

Describe in detail the manner in which the well was plugged, indicating where the mud fluid was placed and the method or methods used in introducing it into the hole. If cement or other plugs were used, state the character of same and depth placed, from _____ feet to _____ feet for each plug set.

1st plug 500' w/40 sx.
2nd plug 250' w/25 sx.
3rd plug 40' w/15 sx.

RECEIVED
STATE CORPORATION COMMISSION
AUG 7 1974
CONSERVATION DIVISION
Wichita, Kansas

(If additional description is necessary, use BACK of this sheet)
Name of Plugging Contractor Woodman & Iannitti Drilling Co.
Address 1008 Union National Bldg., Wichita, Kansas 67202

STATE OF KANSAS, COUNTY OF SEDGWICK, ss.
K. T. WOODMAN (employee of owner) or (owner or operator) of the above-described

well, being first duly sworn on oath, says: That I have knowledge of the facts, statements, and matters herein contained and the log of the above-described well as filed and that the same are true and correct. So help me God.

(Signature) K. T. Woodman

1008 Union National Bldg.
(Address)

SUBSCRIBED AND SWORN to before me this 6th day of August, 1974

My commission expires Feb. 11, 1976

Justina Chamberlain
Notary Public.

K. T. WOODMAN
 RES. PHONE 733-0418
 OFF. PHONE 265-7650
 WICHITA, KANSAS

D. J. IANNITTI
 PHONE 792-2921
 GREAT BEND, KANSAS

WOODMAN & IANNITTI DRILLING COMPANY
Rotary Drilling Contractors

1008 UNION NATIONAL BUILDING
 WICHITA, KANSAS 67202

August 5, 1974

Company;	John C. Bannister and William L. Carey
Farm;	#1 Herb
Location;	SW SE SE
Section;	15-21S-13W
County;	Stafford
Contractor;	Woodman & Iannitti Drilling Co.
Comm;	July 25, 1974
Compl;	August 4, 1974
Total Depth	3688'
Casing;	8 5/8" @ 289 w/225 sx.
Production;	D & A

Figures Indicate Bottom Of Formations:

60	Sand
65	Hard Sand
90	Hard Sand & Pyrite
100	Sand
110	Pyrite
140	Shale & Sand
375	Shale
530	Red Bed
650	Sand
736	Shale
764	Anhy
851	Shale
900	Shale
1040	Shale & Red Bed
1160	Sand
1605	Shale
1980	Lime & Shale
2180	Lime
2540	Shale & Lime
2760	Lime & Shale
2860	Lime
3175	Lime
3425	Lime
3587	Lime
3609	Lime
3650	Chert & Shale
3666	Arbuckle & Dolomite
3688	Arbuckle & Dolomite

RECEIVED
 STATE CORPORATION COMMISSION

AUG 7 1974

CONSERVATION DIVISION
 Wichita, Kansas

Woodman & Iannitti Drilling Co.

K. T. Woodman
 K. T. Woodman