


STATE OF KANSAS  
STATE CORPORATION COMMISSION

WELL PLUGGING RECORD

Give All Information Completely  
Make Required Affidavit  
Mail or Deliver Report to  
Conservation Division  
State Corporation Comm.  
245 North Water  
Wichita, KS 67202

Stafford County. Sec. 15 Twp. 21 Rge. 13 E/W  
Location as "NE/CNW $\frac{1}{4}$ SW $\frac{1}{4}$ " or footage from lines  
NE SW NW

Lease Owner L. D. Davis  
Lease Name Hall Well No. 1  
Office Address Box 324 Great Bend, Ks. 67530  
Character of Well (Completed as Oil, Gas or Dry Hole)

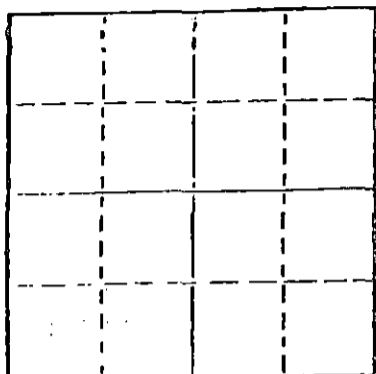

Locate well correctly on above  
Section Plat

Dry Hole  
Date Well completed 7-14- 19 77  
Application for plugging filed 7-15 19 77  
Application for plugging approved 7-15 19 77  
Plugging commenced 7-15 19 77  
Plugging completed 7-15 19 77  
Reason for abandonment of well or producing formation

If a producing well is abandoned, date of last production 19

Was permission obtained from the Conservation Division or  
its agents before plugging was commenced? yes

Name of Conservation Agent who supervised plugging of this well Bud Metz  
Producing formation Depth to top Bottom Total Depth of Well 3658  
Show depth and thickness of all water, oil and gas formations.

OIL, GAS OR WATER RECORDS

CASING RECORD

FORMATION	CONTENT	FROM	TO	SIZE	PUT IN	PULLED OUT

Describe in detail the manner in which the well was plugged, indicating where the mud fluid was placed and the method or methods used in introducing it into the hold. If cement or other plugs were used, state the character of same and depth placed, from feet to feet for each plug set.

Hole full of heavy mud  
Bottom plug at 500' with 40 sacks of 50/50 poz, 3% Gel thru drill pipe  
Middle plug at 240' with 20 sacks cement thru drill pipe  
top plug at 40'  $\frac{1}{2}$  sacks hulls - plug - and 10 sacks cement.  
3 sacks cement in rathole.

FILED  
STATE CORPORATION COMMISSION  
JUL 18 1977  
CONSERVATION DIVISION  
Wichita, Kansas

(If additional description is necessary, use BACK of this sheet)

Name of Plugging Contractor Duke Drilling Co.

STATE OF Kansas COUNTY OF Barton, ss.  
Larry Curtis (employee of owner) or (owner or operator)  
of the above-described well, being first duly sworn on oath, says: That I have knowledge of the facts, statements, and matters herein contained and the log of the above-described well as filed and that the same are true and correct. So help me God.

(Signature) Larry Curtis  
Box 823 - Great Bend, Ks. 67530  
(Address)

SUBSCRIBED AND SWORN TO before me this 15 day of July, 19 77

Maechy M. Hague  
Notary Public.

My commission expires April 11, 1978

Drillers' Well Log

Date Commenced: July 7, 1977  
 Date Completed: July 15, 1977

L. D. Davis  
 Well #1  
 NE SW NW Sec 15-21S-13W  
 Stafford County, Ka.

Elevation: 1899 K.B.

Formation Data

Anhydrite	769
Heebner	3187
Toronto	3208
Douglas	3222
Br. Lime	3314
Lansing KC	3326
Base K.C.	3542
Viola	3562
Simpson	3587
Shuckle	3636
RJD	3658

Surface Pipe: Set used  
 8-5/8", 28ft casing at 336'  
 with 250 sacks 50/50 pozmix, 2%  
 gel, 3% cc.

0 - 85'	Sand
85 - 117'	Hard Sand
117 - 285'	Sand, Hard Sand
285 - 769'	Red Bed
769 - 795'	Anhydrite
795 - 1216'	Shale
1276 - 1806'	Shale & Lime
1806 - 3187'	Lime & Shale
3187 - 3191'	Shale
3191 - 3208'	Lime & Shale
3208 - 3222'	Lime
3222 - 3314'	Shale
3314 - 3326'	Lime & Shale
3326 - 3542'	Lime
3542 - 3562'	Lime & Shale
3562 - 3587'	Lime, Chert, Shale
3587 - 3636'	Shale
3636 - 3658'	Dolomite
3658 -	RJD

Affidavit

 County of Barton ) ss.

Larry Curtis of lawful age does swear and state that the facts and  
 statements herein contained are true and correct to the best of his knowledge.

Larry Curtis

Subscribed and sworn to before me this 15 day of July 1977

My Comm. Expires  
 April 11, 1978

Dorothy M. Hague  
 Notary Public

RECEIVED  
 STATE COMMISSION  
 JUL 18 1977  
 CONSERVATION DIVISION  
 Wichita, Kansas