


WELL PLUGGING RECORD

Give All Information Completely
Make Required Affidavit
Mail or Deliver Report to:
Conservation Division
State Corporation Commission
800 Biting Building
Wichita, Kansas

NORTH

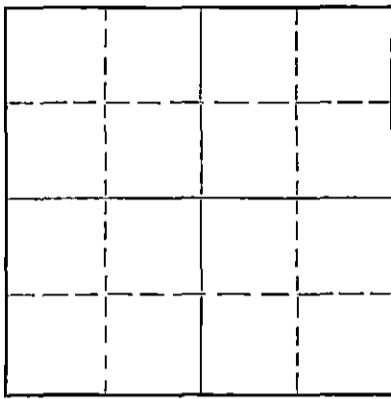

Locate well correctly on above
Section Plat

Stafford County. Sec. 15 Twp. 21 Rge. 13 (E) (W)
Location as "NE/CNW $\frac{1}{4}$ SW $\frac{1}{4}$ " or footage from lines NE NW NW
Lease Owner Petroleum, Inc.
Lease Name Michaux Well No. 1
Office Address 100 Derby Building, Wichita, Kansas
Character of Well (completed as Oil, Gas or Dry Hole) Dry Hole
Date well completed September 4, 1950
Application for plugging filed September 7, 1950
Application for plugging approved September 6, 1950
Plugging commenced September 4, 1950
Plugging completed September 4, 1950
Reason for abandonment of well or producing formation Dry Hole

If a producing well is abandoned, date of last production 19...
Was permission obtained from the Conservation Division or its agents before plugging was commenced? Yes

Name of Conservation Agent who supervised plugging of this well Mr. C. D. Stough
Producing formation Depth to top Bottom Total Depth of Well Feet
Show depth and thickness of all water, oil and gas formations.

OIL, GAS OR WATER RECORDS

CASING RECORD

Formation	Content	From	To	Size	Put In	Pulled Out
				8 5/8"	207'	None

Describe in detail the manner in which the well was plugged, indicating where the mud fluid was placed and the method or methods used in introducing it into the hole. If cement or other plugs were used, state the character of same and depth placed, from feet to feet for each plug set.

Wooden plug set at 204'. Cemented and displaced through drill pipe 15 sax. Filled hole with heavy mud to 30'. Placed wooden plug at 30'. Filled hole to surface with cement.

SEP 8 1950 9-8-1950

(If additional description is necessary, use BACK of this sheet)

Correspondence regarding this well should be addressed to Petroleum, Inc.
Address 100 Derby Building, Wichita, Kansas

STATE OF KANSAS, COUNTY OF SEDGWICK, ss.
Eric H. Jager (employee of owner) of the above-described well,
being first duly sworn on oath, says: That I have knowledge of the facts, statements, and matters herein contained and the log of the above-described well as filed and that the same are true and correct. So help me God.

(Signature) Eric H. Jager
100 Derby Building, Wichita, Kans.
(Address)

SUBSCRIBED AND SWORN to before me this 7th day of September, 1950

Marjorie Bradshaw
Notary Public.

My commission expires October 27, 1952

PLUGGING
FILE SEC-15 T21 R13u
BOOK PAGE 26 LINE 13

15.185.12061.0000

WELL LOG MICHAUX #1

Petroleum, Inc., Lease Owner

Section 15, Twonship 21S, Range 13W

Garvey Oil, Contractor

Location: NE NW NW

Rotary Total Depth: 3641

County: Stafford, Kansas

Commenced: August 21, 1950

Elevation: 1885 D.F.

Completed: September 4, 1950

Casing: 207' of 8 5/8" surface csg.

FIGURES BELOW INDICATE BOTTOM OF FORMATION

20	Shale & Sand	3622	Arbuckle
70	Shale	3625	Lime
104	Sandstone		
225	Shale & Shells	3641	R.T.D. D & A
325	Shale		
400	Red Bed		<u>Tops</u>
695	Shale & Red Bed	740	Anhydrite
740	Red Bed	3180	Heebner
755	Anhydrite	3200	Toronto
1030	Red Bed & Shalls	3215	Base Oread
1185	Shale & Shells	3304	Br. Lime
1830	Lime & Shale	3316	Lansing
1925	Lime	3533	B.K.C.
1985	Lime & Shale	3543	Viola
2680	Shale & Shells	3569	Simpson
2815	Shale & Lime	3618	Arbuckle
3025	Lime		
3245	Shale		
3325	Lime & Shale		
3352	Lime		
3585	Lime & Shale		
3618	Shale		

- D.S.T. #1, open 45 mins. Recovered 30' mud.
- D.S.T. #2, open 30 mins. Recovered 8' mud.
- D.S.T. #3, open 30 mins. Recovered 8' mud.
- D.S.T. #4, open 30 mins. Recovered 12' mud.
- D.S.T. #5, (Misrun)
- D.S.T. #6, open 1 hr. Recovered 22' very slightly oil cut mud.
- D.S.T. #7, open 1 1/2 hrs. Recovered 180' sulphur water.

I hereby certify that this is a true and correct log of the above mentioned well.

PETROLEUM, INC.

PLUGGING
 FILE SEC 15 T 21 R 13W
 BOOK PAGE 26 LINE 12

STATE OF KANSAS
 SEDGWICK COUNTY

Eric H. Jäger

Subscribed to and sworn to before me, a Notary Public in said County and State this 7th day of September, 1950.

Margaret Bradshaw
 Notary Public

My commission expires: October 27, 1952