


STATE OF KANSAS
STATE CORPORATION COMMISSION

WELL PLUGGING RECORD

Give All Information Completely
Make Required Affidavit
Mail or Deliver Report to
Conservation Division
State Corporation Comm.
245 North Water
Wichita, KS 67202

Stafford County, Sec. 15 Twp. 21S Rge. 13W
Location as "NE/CNW $\frac{1}{4}$ /SW $\frac{1}{4}$ " or footage from lines
SE NE NW

Lease Owner Eldon J. Schierling
Lease Name Hall Well No. 2
Office Address 830 Sutton Place, Wichita, KS 67202
Character of Well (Completed as Oil, Gas or Dry Hole)
dry hole

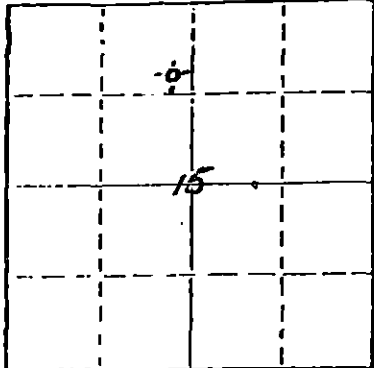

Locate well correctly on above
Section Plot

Date Well completed January 18 19 81
Application for plugging filed January 18 19 81
Application for plugging approved January 18 19 81
Plugging commenced January 18 19 81
Plugging completed January 18 19 81
Reason for abandonment of well or producing formation

If a producing well is abandoned, date of last production 19

Was permission obtained from the Conservation Division or
its agents before plugging was commenced? yes

Name of Conservation Agent who supervised plugging of this well Duane Rankin
Producing formation Depth to top Bottom Total Depth of Well 3650
Show depth and thickness of all water, oil and gas formations.

OIL, GAS OR WATER RECORDS

CASING RECORD

FORMATION	CONTENT	FROM	TO	SIZE	PUT IN	PULLED OUT
surface hole	shale	surface	330	8-5/8	327	none
	cemented with 275 sx common, 2% gel, 3% cc					by Sun
	plug down at 8:15 a.m. 1-13-81					

Describe in detail the manner in which the well was plugged, indicating where the mud fluid was placed and the method or methods used in introducing it into the hold. If cement or other plugs were used, state the character of same and depth placed, from feet to feet for each plug set.

Plugged as follows with 50/50 posmix 2% gel, 3% cc
50 sx @ 500'
20 sx @ 330'
10 sx & solid bridge @ 40'
10 sx in rat hole; job completed at 6:15 p.m. 1-18-81 by Sun.

(If additional description is necessary, use BACK of this sheet) 21 1981

Name of Plugging Contractor Husky Drilling Co., Inc.

STATE OF KANSAS COUNTY OF SEDGWICK
Jon T. Williams, Jr. (employee of owner) or (owner or operator)


of the above-described well, being first duly sworn on oath, says: That I have knowledge of the facts, statements, and matters herein contained and the log of the above-described well as filed and that the same are true and correct. So help me God.

(Signature) *Jon T. Williams, Jr.*
200 E. First, Suite 500, Wichita, KS 67202
(Address)

SUBSCRIBED AND SWORN TO before me this 20th day of January, 19 81

Geraldine Stewart
Geraldine Stewart Notary Public.

My commission expires January 14, 1985

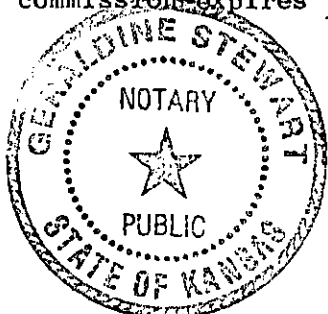



200 East First, Suite 500
~~800 Fitting Blvd~~
Wichita, Kansas 67202
Phone 316 - 263-7904
Mobile Phone 316 - 793-7859 Unit 7070

January 20, 1981

WELL LOG-----Hall No. 2
Located: SE NE NW of Sec. 15-21S-13W, Stafford County, Kansas

OWNER: Eldon J. Schierling
ROTARY CONTRACTOR: Husky Drilling Co., Inc.

COMMENCED: January 12, 1981
COMPLETED: January 18, 1981

Rotary Total Depth: 3650'

LOG

0 - 110 Hard Sand
110 - 160 Shale & hard sand streaks
160 - 210 Shale
210 - 300 Sand
300 - 330 Shale & sand streaks
330 - 737 Shale & Red Bed
737 - 758 Anhydrite
758 - 1775 Shale & shells
1775 - 3410 Shale & lime
3410 - 3540 Lime
3540 - 3650 Lime & shale

CASING RECORD

Ran 8 jts., used 20#, 8-5/8" casing
tallied 320.44' set @ 327 KB w/275
sx common 2% gel, 3% cc, plug down
@ 8:15 a.m. by Sun. cement did circ

Plugged & Abandoned 1-18-81.

I certify the above to be a true and correct copy of the driller's log
to the best of my knowledge and belief.

HUSKY DRILLING CO., INC.

BY Jon T. Williams, Jr.
Jon T. Williams, Jr., President

JAN 21 1981

Wichita, Kansas