

DISTRICT CONSERVATION AGENT'S REPORT

TO:

State Corporation Commission
 Conservation Division
 800 Bitting Building
 Wichita, Kansas

FILE NO. 133-11LOCATION SE-NE-NWSEC. 4 TWP. 21 RGE. 12 WDry Hole Abandoned Oil Well Abandoned Gas Well

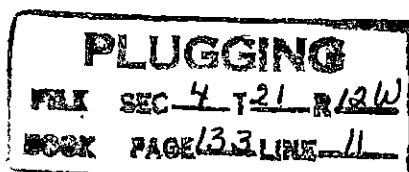
I have this date completed supervision of plugging of:

Well No. 4 Lease DewerffOperator The Texas Company Address 614 Bitting Bldg Wichita KsField _____ County StaffordTotal Depth 3516 Feet.Plugging Contractor Rt S. Pipe Pulling Co.Plugging Contractor's License No. 1.Address Ellinwood, Kansas

RECEIVED
 STATE CORPORATION COMMISSION

JUL 19 1955

(Describe briefly the manner in which the well was plugged) CONSERVATION DIVISION
 Wichita, Kansas

Surface pipe 10 3/4" @ 629' C.W.C. 7" O.D. set 3510up 75 sq cem. F.B. 3201 Top perf. 3170'Sanded hole to 3160' dumped 5 sq cem.shot off and pulled 7" casing Filled holewith heavy mud to 300' set rock bridgeand dumped 25 sq cem. mud to 25' rockbridge and 10 sq cem. to base of cellar

Warren H. Harner
 District Conservation Agent

Date July 17, 1955