

STATE CORPORATION COMMISSION OF KANSAS
OIL & GAS CONSERVATION DIVISION
WELL COMPLETION OR RECOMPLETION FORM
ACO-1 WELL HISTORY
DESCRIPTION OF WELL AND LEASE

Operator: License # 6725
Name Eric Waddell Company
Address Box 349
City/State/Zip Natoma, KS 67651

Purchaser Farmland

Operator Contact Person Eric Waddell
Phone (913) 885-4497

Contractor: License # 5422
Name Abercrombie Drilling, Inc.

Wellsite Geologist Mona Manes
Phone 316-945-8094

Designate Type of Completion

New Well Re-Entry Workover
 Oil SWD Temp Abd
 Gas Inj Delayed Comp.
 Dry Other (Core, Water Supply etc.)

If OWWO: old well info as follows:
Operator
Well Name
Comp. Date Old Total Depth

WELL HISTORY

Drilling Method: Mud Rotary Air Rotary Cable

Spud Date 2-11-89 Date Reached TD 2-19-89 Completion Date 2-19-89

Total Depth 4850' PBDT 4849' 325.68'

Amount of Surface Pipe Set and Cemented at...feet
Multiple Stage Cementing Collar Used? Yes No
If yes, show depth set...feet
If alternate 2 completion, cement circulated from...feet depth to...w/...SX cmt
Cement Company Name
Invoice #


AIT I

INSTRUCTIONS: This form shall be completed in triplicate and filed with the Kansas Corporation Commission, 200 Colorado Derby Building, Wichita, Kansas 67202, within 120 days of the spud date of any well. Rule 82-3-130, 82-3-107 and 82-3-106 apply. Information on side two of this form will be held confidential for a period of 12 months if requested in writing and submitted with the form. See rule 82-3-107 for confidentiality in excess of 12 months. One copy of all wireline logs and drillers time log shall be attached with this form. Submit CP-4 form with all plugged wells. Submit CP-111 form with all temporarily abandoned wells.

All requirements of the statutes, rules and regulations promulgated to regulate the oil and gas industry have been fully complied with and the statements hereid are complete and correct to the best of my knowledge.

Signature [Signature]
Title Operator S.T. Date 6-8-89

Subscribed and sworn to before me this 8 day of June 19 89
Notary Public Reva F. Musgrove
Date Commission Expires 3-28-92

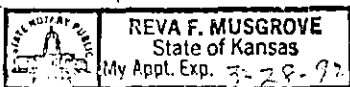

API NO. 15-097-21,268-0000

County Kiowa
Approx
C N/2 N/2 Sec 13 Twp 28S Rge 17 East
X West

4800 Ft North from Southeast Corner of Section
2570 Ft West from Southeast Corner of Section
(Note: Locate well in section plat below)


Lease Name Bevans Well # 1

Field Name N/A Haviland, NW

Producing Formation Mississippian

Elevation: Ground 2159' KB 2164

Section Plat

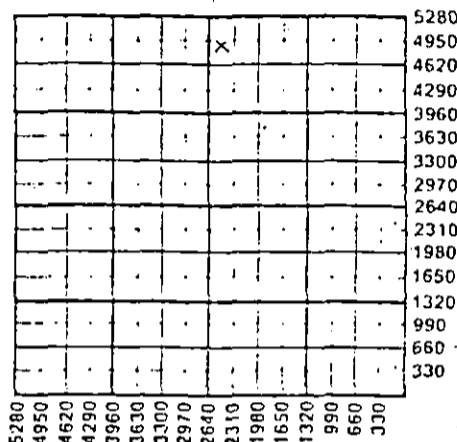

WATER SUPPLY INFORMATION

Disposition of Produced Water: Disposal
Docket # Repressuring

Questions on this portion of the ACO-1 call:

Water Resources Board (913) 296-3717

Source of Water:
Division of Water Resources Permit # 189-072

Groundwater 4850 Ft North from Southeast Corner
(Well) 2700 Ft West from Southeast Corner of
Kiowa Co Sec 13 Twp 28S Rge 17 East X West

Surface Water...Ft North from Southeast Corner
(Stream, pond etc)...Ft West from Southeast Corner
Sec Twp Rge East West

Other (explain)
(purchased from city, R.W.D. #)

K.C.C. OFFICE USE ONLY
 Letter of Confidentiality Attached
 Wireline Log Received
 Drillers Timelog Received
Distribution
 KCC SWD/Rep NGPA
 KGS Plug Other
(Specify)
6-9-89

Sec 13 Twp 28S Rge 17E