


STATE OF KANSAS
STATE CORPORATION COMMISSION

Form CP-4

Give All Information Completely
Make Required Affidavit
Mail or Deliver Report to:
Conservation Division
State Corporation Commission

WELL PLUGGING RECORD

P. O. Box 17027
Wichita, Kansas 67217
NORTH

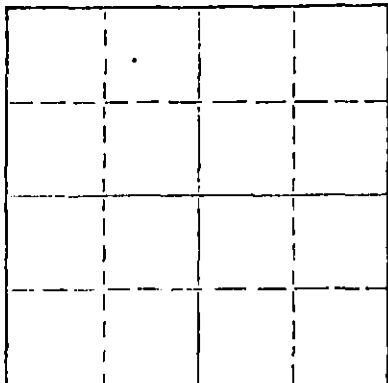

Locate well correctly on above
Section Plat

Rice County. Sec. 11 Twp. 21S Rge. 9W (EX) (W)
Location as "NE/CNW&SW&" or footage from lines SE NE NE
Lease Owner Lebsack Oil Production, Inc.
Lease Name Stewart #B-1 Well No. 1
Office Address P. O. Box 1489, Hays, Kansas 67601
Character of Well (completed as Oil, Gas or Dry Hole) Dry Hole
Date well completed June 7, 1974 19
Application for plugging filed June 6, 1974 19
Application for plugging approved June 6, 1974 19
Plugging commenced 8:00 AM, June 7, 1974 19
Plugging completed 10:00 AM, June 7, 1974 19
Reason for abandonment of well or producing formation Dry Hole
If a producing well is abandoned, date of last production 19
Was permission obtained from the Conservation Division or its agents before plugging was commenced? Yes

Name of Conservation Agent who supervised plugging of this well Gilbert Toman
Producing formation _____ Depth to top _____ Bottom _____ Total Depth of Well 3450' Feet
Show depth and thickness of all water, oil and gas formations.

OIL, GAS OR WATER RECORDS

CASING RECORD

| FORMATION | CONTENT | FROM | TO | SIZE | PUT IN | PULLED OUT |
|-----------|---------|------|----|--------|--------|------------|
| | | | | 8 5/8" | 203' | None |
| | | | | | | |
| | | | | | | |
Describe in detail the manner in which the well was plugged, indicating where the mud fluid was placed and the method or methods used in introducing it into the hole. If cement or other plugs were used, state the character of same and depth placed, from _____ feet to _____ feet for each plug set.

Filled hole with heavy mud.
Heavy mud to 340' with 40 sacks @ 1,50'.
Heavy mud to 195' with 25 sacks @ 195'.
Heavy mud to 40' with plug, hulls and solid bridge with 10 sacks to surface and 2 sacks in rathole.

RECEIVED
STATE CORPORATION COMMISSION
JUN 14 1974
CONSERVATION DIVISION
Wichita, Kansas

RECEIVED
STATE CORPORATION COMMISSION
JUN 12 1974
CONSERVATION DIVISION
Wichita, Kansas

(If additional description is necessary, use BACK of this sheet)
Name of Plugging Contractor Sterling Drilling Company
Address P. O. Box 129, Sterling, Kansas 67579

STATE OF KANSAS COUNTY OF RICE, ss.
F. A. Wuellner (employee of owner) or (owner or operator) of the above-described

well being first, duly sworn on oath, says: That I have knowledge of the facts, statements, and matters herein contained and the log of the above-described well as filed and that the same are true and correct. So help me God.

(Signature) [Signature]
STERLING DRILLING COMPANY
F. A. Wuellner, Secretary
P. O. Box 129, Sterling, Kansas 67579
(Address)

Subscribed and Sworn to before me this 10th day of June, 19 74.



CHARLES M. HALL—NOTARY PUBLIC
My Commission Expires Jan. 6, 1978

[Signature]
Charles M. Hall, Notary Public.

15.159.20500.0000

STERLING DRILLING COMPANY
P. O. Box 129
Sterling, Kansas 67579

WELL LOG ----- STEWART #1B-1

Located: App SE NE NE, Section 11-21S-9W, Rice County, Kansas

OWNER: Lebsack Oil Production, Inc.
ROTARY DRILLING CONTRACTOR: Sterling Drilling Company

COMMENCED: May 31, 1974
COMPLETED: June 7, 1974

TOTAL DEPTH: 3450'

RECEIVED
STATE CORPORATION COMMISSION
JUN 14 1974
CONSERVATION DIVISION
Wichita, Kansas

LOG

CASING RECORD

0 - 100 Sand and Clay
100 - 400 Shale
400 - 1335 Shale and Salt
1335 - 1545 Shale
1545 - 3205 Lime and Shale
3205 - 3295 Lime
3295 - 3450 Lime and Shale

Ran 5 joints 8 5/8" casing, 191.50' set
at 203' K.B. Cemented with 225 sacks
Pozmix, 3% cc. Plug down at 5:00 AM,
6-1-74.

Plugged.

RECEIVED
STATE CORPORATION COMMISSION
JUN 12 1974
CONSERVATION DIVISION
Wichita, Kansas