

STATE OF KANSAS  
STATE CORPORATION COMMISSION

WELL PLUGGING RECORD

Give All Information Completely  
None Required Affidavit  
Mail or Deliver Report to:  
Conservation Division  
State Corporation Commission  
890 Bittling Building  
Wichita, Kansas

Kiowa County. Sec. 14 Twp. 28 Rge. 17 (E) (W)

Location as "NE/CNW/SW" or footage from lines NW/CSW SW

Lease Owner Sun Oil Company

Lease Name I. G. Ross Well No. 1

Office Address Box 1348, Tulsa, Oklahoma

Character of Well (completed as Oil, Gas or Dry Hole) Dry hole

Date well completed December 25 19 53

Application for plugging filed Jan. 7 19 54

Application for plugging approved December 26 19 53

Plugging commenced December 26 19 53


Plugging completed December 26 19 53

Reason for abandonment of well or producing formation

Wildcat well that had no shows

If a producing well is abandoned, date of last production 19

Was permission obtained from the Conservation Division or its agents before plugging was commenced? Yes

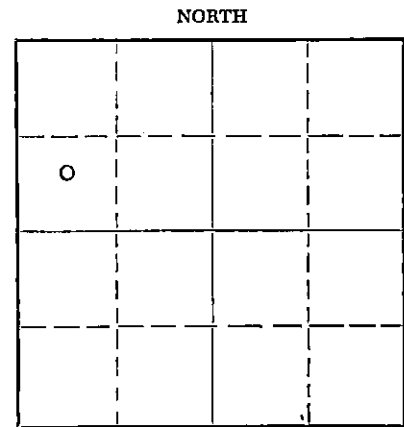

Locate well correctly on above Section Flat

Name of Conservation Agent who supervised plugging of this well M. A. Rives

Producing formation Depth to top Bottom Total Depth of Well 5102 Feet

Show depth and thickness of all water, oil and gas formations.

OIL, GAS OR WATER RECORDS

CASING RECORD

FORMATION	CONTENT	FROM	TO	SIZE	PUT IN	PULLED OUT
No formations tested				10-3/4"	736'	None

Describe in detail the manner in which the well was plugged, indicating where the mud fluid was placed and the method or methods used in introducing it into the hole. If cement or other plugs were used, state the character of same and depth placed, from feet to feet for each plug set.

25 sack cement plug from 211' to 250'

8 sack cement plug from 24' to 40'

2 sack cement plug from 0' to 4'

1-16-54  
STATE OF KANSAS  
JAN 16 1954  
CONSERVATION DIVISION  
KANSAS

(If additional description is necessary, use BACK of this sheet)

Name of Plugging Contractor Stickle Drilling Company

Address Philtower Bldg., Tulsa, Oklahoma

STATE OF OKLAHOMA COUNTY OF TULSA, ss.

J. H. Allen (employee of owner) or (owner or operator) of the above-described well, being first duly sworn on oath, says: That I have knowledge of the facts, statements, and matters herein contained and the log of the above-described well as filed and that the same are true and correct. So help me God.

(Signature) J. H. Allen

Box 1348, Tulsa, Oklahoma

(Address)

SUBSCRIBED AND SWORN TO before me this 11 day of Jan, 1954

J. Blanchard + oth  
Notary Public.

My commission expires 5-9-55

PLUGGING  
NW/4 SEC 14 T 28 R 17W  
BOOK PAGE 4 LINE 16

DRILLERS' LOG

SUN OIL COMPANY  
 I. G. Ross No.1  
 SW/4 SW/4 NW/4  
 Sec. 14, Twp. 28S, Rge. 17W  
 Kiowa County, Kansas

ELEV. D.F. 2178'

<u>FORMATION</u>	<u>FROM</u>	<u>TO</u>	
Clay, sand & shale	0	1100	Drilling Commenced: 12-3-53
Anhydrite	1100	1130	Drilling Completed: 12-24-53
Red bed & shale	1130	1550	
Salt, shale & lime	1550	2170	Dry and Abandoned
Lime & broken shaly ls.	2170	4060	
Shale & limey shale	4060	4212	
Lansing Lime	4212	4769	CASING RECORD:
Miss. Lime	4769	4891	
Viola Lime	4891	5002	12-5-53: 10-3/4" 32.75# H40 casing
Simpson (sh., sd., dolo.)	5002	5079	set at 745.63' with 700 sacks reg.
Arbuckle Lime	5079	5102	cement.
		T.D.	

I hereby certify that the foregoing is a true and correct copy of the I. G. Ross No. 1 Well Log as it is recorded on the books of the Sun Oil Company.

*J. H. Allen*  
 J. H. Allen

STATE OF OKLAHOMA }  
 COUNTY OF TULSA } SS

RECEIVED  
 STATE COMMISSION  
 JAN 16 1954  
 CONSERVATION DIVISION  
 Wichita, Kansas

Subscribed and sworn to before me this 15 day of January, 1954.

*Robert F. ...*  
 Notary Public

My Commission Expires:  
May 9, 1955

**PLUGGING**  
 FILE SEC 14 T 28 R 17W  
 BOOK PAGE 4 LINE 16