


STATE OF KANSAS
STATE CORPORATION COMMISSION

Give All Information Completely
Make Required Affidavit
Mail or Deliver Report to:
Conservation Division
State Corporation Commission
212 No. Market
Wichita, Kansas

WELL PLUGGING RECORD

NORTH

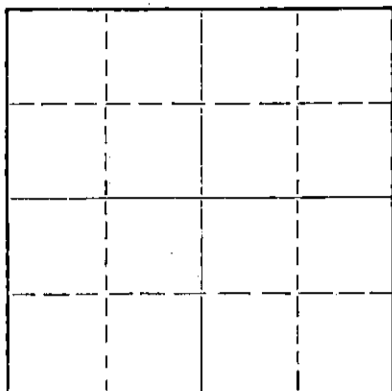

Locate well correctly on above
Section Plat

Rice County. Sec. 2 Twp. 21 Rge. 9 (E) (W)
Location as "NE/CNW/SW" or footage from lines NE SW SE
Lease Owner Great Bend Pipe & Supply
Lease Name Schafer Well No. 1
Office Address Great Bend, Kansas
Character of Well (completed as Oil, Gas or Dry Hole)
Date well completed 19__
Application for plugging filed 19__
Application for plugging approved 19__
Plugging commenced 11/6/67 19__
Plugging completed 11/7/67 19__
Reason for abandonment of well or producing formation depleted.

If a producing well is abandoned, date of last production 19__
Was permission obtained from the Conservation Division or its agents before plugging was commenced? yes

Name of Conservation Agent who supervised plugging of this well Toman
Producing formation Depth to top Bottom Total Depth of Well 2950 Feet
Show depth and thickness of all water, oil and gas formations.

OIL, GAS OR WATER RECORDS

CASING RECORD

FORMATION	CONTENT	FROM	TO	SIZE	PUT IN	PULLED OUT
				8-5/8"	234'	none
				5-1/2"	2942'	2488'

Describe in detail the manner in which the well was plugged, indicating where the mud fluid was placed and the method or methods used in introducing it into the hole. If cement or other plugs were used, state the character of same and depth placed, from feet to feet for each plug set.

Checked hole to 2945', sanded to 2925' and ran 5 sacks of cement.
Cleaned cellar, loaded hole, shot pipe at 2472', worked pipe loose
and pulled 5 1/2" casing. Set 10' rock bridge at 230' and ran 20 sacks
of cement. Mudded hole to 30' and ran 10 sacks of cement. Talled
pipe.

PLUGGING COMPLETE.

RECEIVED
STATE CORPORATION COMMISSION
NOV 13 1967
11-13-67
CONSERVATION DIVISION
Wichita, Kansas

(If additional description is necessary, use BACK of this sheet)
Name of Plugging Contractor KNIGHT CASING PULLING COMPANY
Address CHASE, KANSAS 67524

STATE OF KANSAS COUNTY OF RICE, ss.
NOEL J. KNIGHT (employee of owner) or (owner or operator) of the above-described well, being first duly sworn on oath, says: That I have knowledge of the facts, statements, and matters herein contained and the log of the above-described well as filed and that the same are true and correct. So help me God.

(Signature) Noel Knight
CHASE, KANSAS
(Address)

SUBSCRIBED AND SWORN TO before me this 8th day of November, 19 67

My commission expires February 15, 1971
Margaret Melcher Notary Public.

15.159.30041.0000

E. H. Adair Oil Company
1005 East Second Street
Wichitâ, Kansas

Lee Phillips Oil Company and
E. H. Adair Oil Company
Don Schafer No. 1 "C"
NE-SW-SE of
Sec. 2-21-9W
Rice County, Kansas

Comm: 3-29-65
Comp: 4-2-65
Contractor: Isern Drilling
Company
8 5/8 @ 234 w/185 SX
5 1/2 @ 2942 w/75 SX

Elev: 1676 K. B.

Figures indicate bottom of formations:

Shale and Lime	2400
Lime	2754
Black Shale	2758
Lime	2789
Shale and Lime	2815
Sandy Shale	2822
Shale	2889
Lime	2897
Lime and Shale	2920
Lime	2950
T. D.	2950

RECEIVED
STATE CORPORATION COMMISSION
APR 26 1961

CONSERVATION DIVISION
Wichita, Kansas

SAMPLE TOPS:

HEEBNER	2754	(-1078)
DOUGLAS	2789	(-1113)
BROWN LIME	2889	(-1213)
LANSING	2920	(-1244)
T. D.	2950	

DST #1: 2935 - 50.

Open two hours. Gas to surface in 2 minutes, gauged 537,000 and decreased to 196,000 at the end of the test. Recovered 780 feet of gassy oil.

IBHP = 1063 # in 20 minutes.

FBHP = 978# in 30 minutes.

IFP = 90# FFP = 117#

Certified Correct:

Sherrill Compton
Sherrill Compton - Geologist